

FILED

Date: 9-16-2003 By: Jc

This survey consists of:

Map: \_\_\_\_\_

Name: \_\_\_\_\_

Corner Rpt: 65/48-14

DOUGLAS COUNTY  
SURVEYOR

OREGON CORNER RESTORATION FORM

Section 26 Township 26S Range 3W

County DOUGLAS Date 8-28-03

Corner Designation

C<sup>1</sup>/<sub>4</sub> 540240

- Condition Report Only
- Not Found
- Renewed
- Unrecorded
- Surveyed In
- Referenced Out

Previous Renewals/Surveys, etc. \_\_\_\_\_


Monument(s) & Accessories Found: (Condition and Source)

1972 BLM IPBC

14" MAPLE N33E 8<sup>4</sup> (TAG SIDE 10<sup>5</sup>) HEALED

25" FIR S4E 21<sup>2</sup> (TAG SBE 18<sup>5</sup> (REC 19<sup>5</sup>)) HEALED

Monument Detail

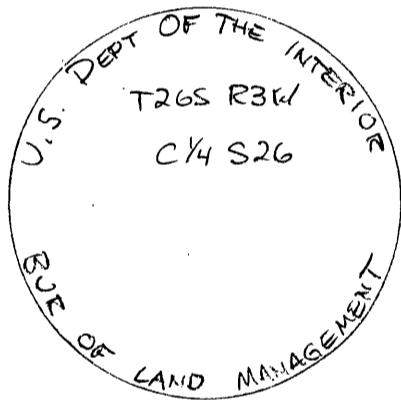

Sketch

Monument Set (Procedures and Description)

New Accessories

17" FIR S18W 15<sup>3</sup> SCRIBED "C<sup>1</sup>/<sub>4</sub> BT"

10" MAPLE N74W 48<sup>4</sup> SCRIBED "C<sup>1</sup>/<sub>4</sub> BT"

Location & Comments

Compass Declination 19<sup>1</sup>/<sub>2</sub>

Firm/Agency ROSEBURG FOREST PRODUCTS

Address PO Box 1088


ROSEBURG OREGON 97470

Party Chief Bill Olson

Notes MIKE FRODALL

Witness \_\_\_\_\_

Surveyor's Seal

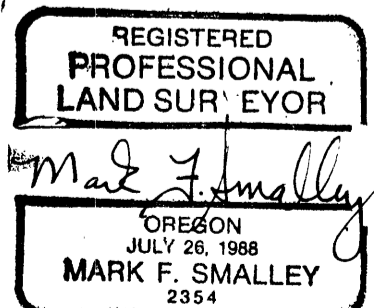

RENEWS 6/30/04

C.S. File No 65/48-14