

FILED

Date: 9-16-2003 By: JC

This survey consists of:

Map: \_\_\_\_\_

Narrative: \_\_\_\_\_

Corner Rpt: 65/48-17

OREGON CORNER RESTORATION FORM

Section 26 Township 26S Range 3W

County DOUGLAS Date 9-2-03

DOUGLAS COUNTY  
SURVEYOR

Corner Designation

E 1/4 26/25 600240

- Condition Report Only
- Not Found
- Renewed
- Unrecorded
- Surveyed In
- Referenced Out

Previous Renewals/Surveys, etc. \_\_\_\_\_


Monument(s) & Accessories Found: (Condition and Source)

FOUND 1972 BLM IPBC

BTs: 22" FIR N69W/ 16<sup>S</sup> HEALED

28" FIR N51E 17<sup>E</sup> HEALED

Monument Detail

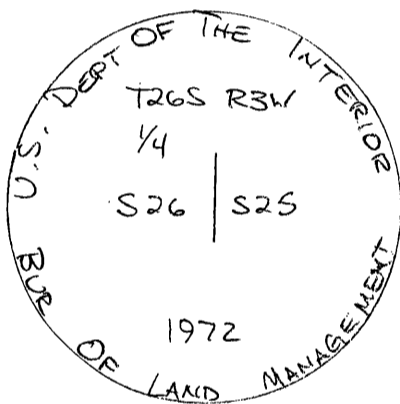

Sketch

Monument Set (Procedures and Description)

New Accessories

9" FIR S6E 14<sup>E</sup> SCRIBED "1/4S BT"

7" FIR S41W 19<sup>E</sup> SCRIBED "1/4S BT"

Location & Comments

Compass Declination 19 1/2

Firm/Agency ROSEBURG

FOREST PRODUCTS

Address PO Box 1088

ROSEBURG OREGON 97470

Party Chief Bill Olson

Notes \_\_\_\_\_

Witness Mike Frowdahl

Surveyor's Seal

REGISTERED  
PROFESSIONAL  
LAND SURVEYOR

Mark F. Smalley  
OREGON  
JULY 26, 1988  
MARK F. SMALLEY  
2354

RENEWS 10/30/03

C.S. File No 65/48-17