

FILED

Date: 9-16-2003 By: X

This survey consists of:
Map: _____

Corner Fpt: 65/48-18

OREGON CORNER RESTORATION FORM

Section 12 Township 29S Range 4

County DOUGLAS Date 9-2-03

DOUGLAS COUNTY
SURVEYOR

Corner Designation

W. $\frac{1}{16}$ $\frac{12}{13}$

- Condition Report Only
- Not Found
- Renewed
- Unrecorded
- Surveyed In
- Referenced Out

Previous Renewals/Surveys, etc.
CS 65/18-1

Monument(s) & Accessories Found: (Condition and Source)

1998 ALUMINUM CAP & IRON ROD

BTS: 16" FIR S66E 19° SCRIBE VISIBLE (RECORD S57E)
(BT TAG ON TREE READS N66W 19°)

10" FIR N36E 23° HEALED (RECORD N32E)
(BT TAG ON TREE READS S36W 23°)

Monument Detail

Sketch




Monument Set (Procedures and Description)

New Accessories

Location & Comments

Compass Declination 19 1/2
 Firm/Agency ROSEBURG FOREST PRODUCTS
 Address PO Box 1088 ROSEBURG OREGON 97470
 Party Chief Bill Olson
 Notes _____
 Witness Mike Fromdahl

Surveyor's Seal

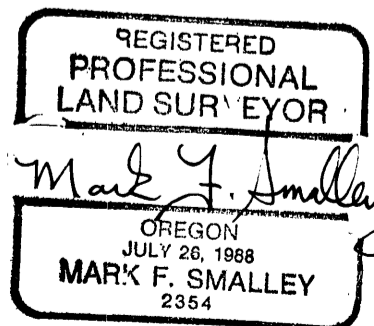

RENEWS 6/30/04

C.S. File No 65/48-18