

FILED

Date: 9-16-2003 By: JC

This survey consists of:

Map: \_\_\_\_\_

Name: \_\_\_\_\_

Corner Rpt: 65/48-19

DOUGLAS COUNTY  
SURVEYOR

OREGON CORNER RESTORATION FORM

Section 12 Township 29S Range 4W

County DOUGLAS Date 9-2-03

Corner Designation

S  $\frac{1}{4}$  SECTION 12  $\frac{12}{13}$

- Condition Report Only
- Not Found
- Renewed
- Unrecorded
- Surveyed In
- Referenced Out


Previous Renewals/Surveys, etc. 640500

Monument(s) & Accessories Found: (Condition and Source)

1964 RLM IPBC

BTs: 24" FIR S8 $\frac{1}{2}$ W	13 $\frac{2}{3}$	HEALED
9" CEDAR N22W	14 $\frac{5}{8}$	SCRIBE VISIBLE
FIR NORTH	43 $\frac{6}{8}$	DOWN-ROTTEN

Monument Detail

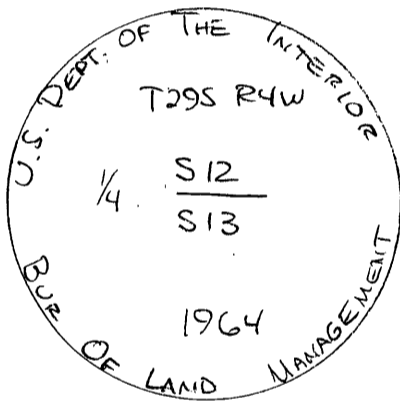

Sketch

Monument Set (Procedures and Description)


New Accessories

BTs: 7" CEDAR S62W	9 $^{\circ}$	SCRIBED	" $\frac{1}{4}$ S13 BT"
7" FIR N20E	16 $^{\circ}$	SCRIBED	" $\frac{1}{4}$ S12 BT"

Location & Comments

Compass Declination 19 $\frac{1}{2}$   
 Firm/Agency ROSERUEG FOREST PRODUCTS  
 Address PO Box 1088 ROSEBURG OREGON 97470  
 Party Chief Bill Olson  
 Notes \_\_\_\_\_  
 Witness Mike Fromdahl

Surveyor's Seal

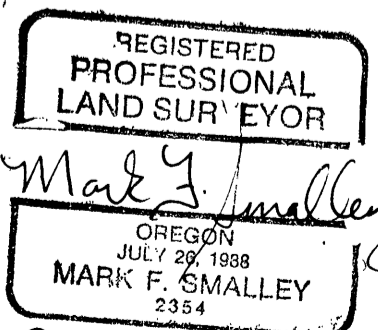

C.S. File No 65/48-19