

FILED

Date: 9-16-2003 JC

OREGON CORNER RESTORATION FORM

Section 12 Township 29S Range 4W

County DOUGLAS Date 9-02-03

Corner Designation

E 1/4 SECTION 12.

- Condition Report Only
- Not Found
- Renewed
- Unrecorded
- Surveyed In
- Referenced Out

Previous Renewals/Surveys, etc.


700 540

Monument(s) & Accessories Found: (Condition and Source)

1964 BLM CADASTRAL IPBC

BTs: 33" CEDAR S33 1/2 W 642 HEALED

Monument Detail

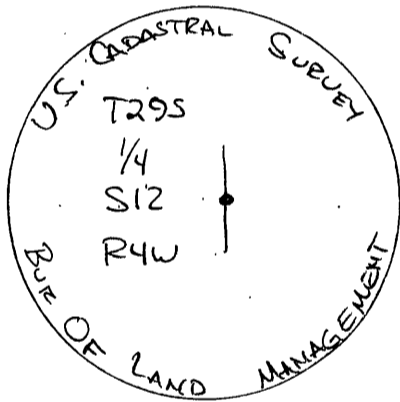

Sketch

Monument Set (Procedures and Description)


New Accessories

BTs: 10" CEDAR N16W 25° SCRIBED "1/4 S BT"
10" FIR N84W 39° SCRIBED "1/4 S BT"

Location & Comments

Compass Declination 19 1/2
 Firm/Agency ROSEBURG FOREST PRODUCTS
 Address PO Box 1088 ROSEBURG OREGON 97470
 Party Chief Bill Olson
 Notes _____
 Witness Mike Froudehl

Surveyor's Seal

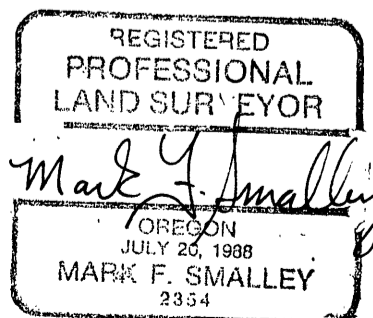

RENEWS 6/30/04

C.S. File No 65/48-21