

FILED

Date: 10-23-2003 By: X

This survey consists of:

Map: _____

Narrative: _____

Corner Rpt: 65/48-22

DOUGLAS COUNTY
SURVEYOR

OREGON CORNER RESTORATION FORM

Section 30 Township 29S Range 7W

County DOUGLAS Date 9-8-03

Corner Designation

NE COR SECTION 30
200300

- Condition Report Only
- Not Found
- Renewed
- Unrecorded
- Surveyed In
- Referenced Out

Previous Renewals/Surveys, etc. _____


Monument(s) & Accessories Found: (Condition and Source)

1924 GLO IPBC

<u>15" FIR N117W</u>	<u>24 1/4</u>	<u>HEALED</u>
<u>21" FIR N68 1/4 E</u>	<u>17 1/2</u>	<u>HEALED</u>
<u>22" FIR S65E</u>	<u>25 1/4</u>	<u>HEALED</u>
<u>15" FIR S23W</u>	<u>17 1/2</u>	<u>HEALED</u>

Monument Detail

Sketch

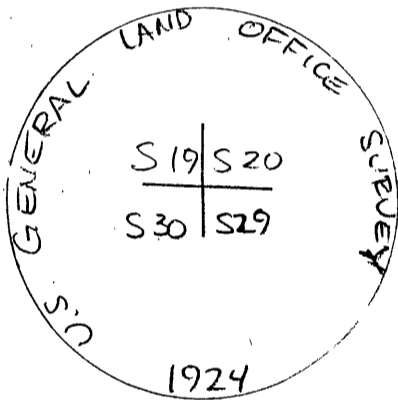


Monument Set (Procedures and Description)

New Accessories

Location & Comments

Surveyor's Seal

Compass Declination 19 1/2
 Firm/Agency ROSEBURG
FOREST PRODUCTS
 Address PO Box 1088
ROSEBURG OREGON 97470
 Party Chief Bill Olson
 Notes _____
 Witness Mike Fromdahl

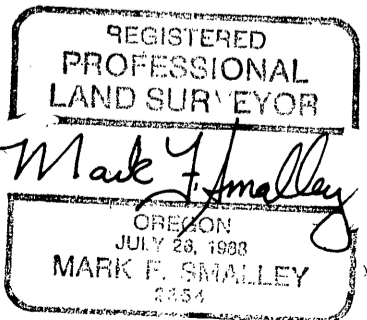

RENEWS 6/30/04

C.S. File No 65/48-22