

FILED

Date: 10-23-2003 By: JC

This survey consists of:

Map: _____

Narrative: _____

Corner Rpt: CS-65/48-23

OREGON CORNER RESTORATION FORM

Section 30 Township 29S Range 7W

County DOUGLAS Date 9-08-03

Corner Designation

E 1/4 SECTION 30
200240

DOUGLAS COUNTY
SURVEYOR


- Condition Report Only
- Not Found
- Renewed
- Unrecorded
- Surveyed In
- Referenced Out

Previous Renewals/Surveys, etc. _____

Monument(s) & Accessories Found: (Condition and Source)

- 1924 GLO IPBC
- 8" FIR S32W 16° HEALED FACE
- 14" LAUREL S11 1/2 W 56° DEAD (5' TALL STOB)
- 9" CEDAR N27W 25° SCRIBE VISIBLE
- 10" CEDAR N25W 40° SCRIBE VISIBLE
- 30" B. OAK STUMP N82 1/2 E 71° (UNDER BLACK BERRY BUSH) (ORIGINAL)

Monument Detail

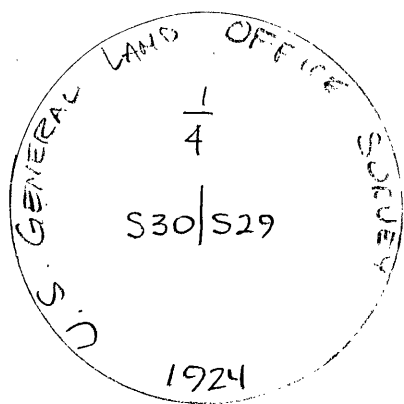

Sketch

Monument Set (Procedures and Description)


New Accessories

- 7" FIR S34E 21° SCRIBED "1/4 S BT"
- 24" FIR N56W 35° SCRIBED "1/4 S BT"

Location & Comments

Compass Declination 19 1/2
 Firm/Agency ROSEBURG FOREST PRODUCTS
 Address PO Box 1098 ROSEBURG OREGON 97470
 Party Chief Bill Olson
 Notes _____
 Witness MICHAEL FROMMANN

Surveyor's Seal

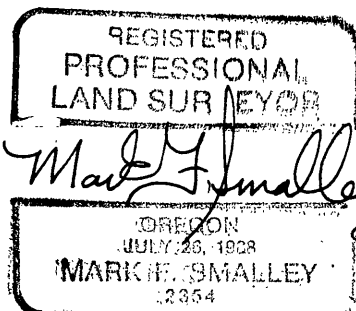

RENEWS 6/30/04

C.S. File No 65/48-23