

FILED

Date: 11-14-2003 By: JC

This survey consists of:

Map: _____

Narrative: _____

Corner Rpt: 65/48-40

OREGON CORNER RESTORATION FORM

Section 16 Township 31S Range 8W

County DOUGLAS Date 10-14-03

DOUGLAS COUNTY SURVEYOR

Corner Designation

S17/S16
S20/S21

- Condition Report Only
- Not Found
- Renewed
- Unrecorded
- Surveyed In
- Referenced Out

Previous Renewals/Surveys, etc.

R-34


Monument(s) & Accessories Found: (Condition and Source)

1958 D.C.S.O. I.P.B.C.

<u>BTs: 32" FIR S11E</u>	<u>15.8'</u>	<u>GOOD</u>	<u>O.B.T.</u>
<u>40" FIR N32 1/2 W</u>	<u>10.9'</u>	<u>GOOD</u>	
<u>18" FIR S53 W</u>	<u>33.0'</u>	<u>CUT DOWN</u>	
<u>6" FIR N35E</u>	<u>56.6'</u>	<u>GONE</u>	
<u>26" FIR S44W</u>	<u>36.7'</u>	<u>GOOD</u>	

Monument Detail

Sketch

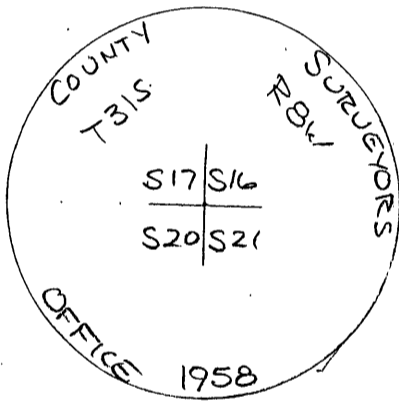

Monument Set (Procedures and Description)

New Accessories

BTs: 21" FIR S18W 22^s SCRIBED "S 20 BT"

Location & Comments

Compass Declination 19°

Firm/Agency Roseburg Forest Products


Address P.O. Box 1088 Roseburg Oregon 97470

Party Chief Bill Olson

Notes _____

Witness Mike Fromdahl

Surveyor's Seal

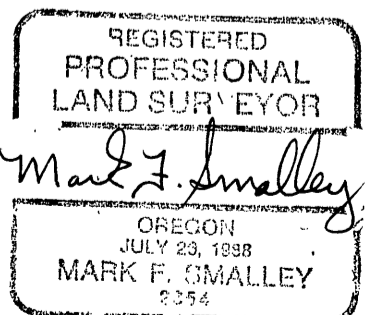

RENEWS 6/30/04

C.S. File No 65/48-40