

FILED

Date: 11-14-2003 By: JC

This survey consists of:

Map: _____

Narrative: _____

Corner Rpt: 65/48-43

OREGON CORNER RESTORATION FORM

Section 35 Township 24S Range 6W

County DOUGLAS Date 10-22-03

DOUGLAS COUNTY
SURVEYOR

Corner Designation

540100

($\frac{1}{4}$ $\frac{35}{2}$)

- Condition Report Only
- Not Found
- Renewed
- Unrecorded
- Surveyed In
- Referenced Out

Previous Renewals/Surveys, etc.

M134-64

Monument(s) & Accessories Found: (Condition and Source)

5/8" I.R.

BTs: 30" FIR STUMP S32E 11° (3' TALL) HEALED

12" FIR N27W 31' HEALED

Monument Detail

Sketch

Monument Set (Procedures and Description)

New Accessories

BTs: 7" FIR N40W 29° SCRIBED "1/4 S BT"

12" FIR N22E 25° SCRIBED "1/4 S BT"

27" FIR N58E 24° SCRIBED "1/4 S BT"

Location & Comments

Compass Declination 20°

Firm/Agency Roseburg

Forest Products

Address P.O. Box 1088


Roseburg Oregon 97470

Party Chief Bill Olson

Notes _____

Witness Mike Frenckel

Surveyor's Seal

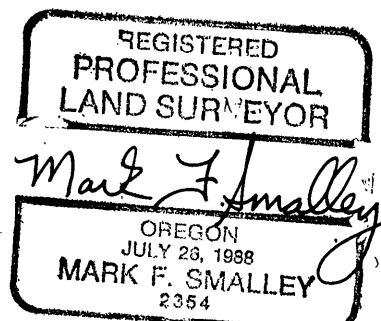

RENEWS 6/30/04

C.S. File No 65/48-43