

FILED

Date: 3-8-2004 By: sc

This survey consists of:

Map: _____

Narrative: _____

Corner Rpt: 65/49-11

OREGON CORNER RESTORATION FORM

Section: 20 Township: 20S Range: 11W

**DOUGLAS COUNTY
SURVEYOR**

County: Douglas Date: 12/19/03

Corner Designation

SE 1/16 S20 as established by Ron Durham
(see CS 55/65)

- Condition Report Only
- Not Found
- Renewed
- Unrecorded
- Surveyed In
- Referenced Out

Previous Renewals/Surveys, etc.:

1964 unrecorded survey by Walter Camp, 1967 survey by Ron Durham M35-74 & CS 55/65.

Monument(s) & Accessories Found: (Condition and Source)

Fd. 2" aluminum pipe slid downhill out of position from the Fd BT's:


34" rotten Cedar stump, S13°W 24.4FT, rescribed "XBT" and placed new tag.

42" rotten Fir stump, S20°W 22.5FT, no visible marks.

47" rotten Spruce stump, N63°W 38.3Ft, no visible marks.

Monument Detail:

Sketch:

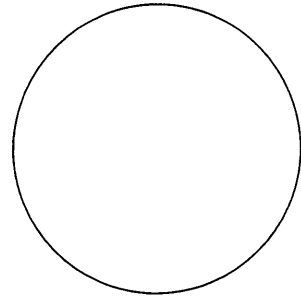

Monument Set (Procedures and Description):

Reset Fd. 2" aluminum pipe at record distance intersect from the found BT's

New Accessories:

13" Fir, N72°W 40.6FT, scribed "XBT".

16" Fir, N2°W 43.5FT, scribed "XBT".

Location and Comments:

Due to previous use by surveys and acceptance, and use by the land-owners, this corner was restored as per the previous records. Ties were made to my survey M 140-10 to help verify the corner. Distances were measured to a spike set at side center on new BT's.

Compass Declination: 18°E

Firm/Agency: Menasha

Forest Products Corp.

Address: PO Box 588


North Bend, OR 97459

Party Chief: Brent Bacon

Notes: Brent Bacon

Witness: _____

Surveyor's Seal

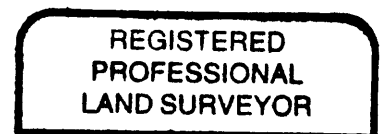

Brent W. Bacon

