

**Township 21 South, Range 8 West
Section 32**

SE Corner Section 32: Found 1945 Brass Cap on Iron Pipe firmly set. We set a 6 foot galvanized steel fence post alongside with top painted red.

Old Bearing Trees Taken in 1945 to Witness Corner by GLO:

38" D. Fir is down, N 45 ½ ° E, 35 feet with healed face.

18" rotted Cedar Stump, N 70° W, 36.3 feet no marks, no tag.

31" D. Fir Snag, N 53° E, 43.6 feet with healed face and tag.

Bearing Trees Taken in 1997 by Douglas County Surveyor:

22" W. Fir, N 47° W, 14.6 feet with visible scribe and aluminum tag

11" Maple, N 60° E, 20.2 feet with healed face and aluminum tag

17" W. Fir, N 80° E, 69.3 feet with healed face and aluminum tag

FILED

Date: 3/8/2004 By: BC


This survey consists of:

Map: _____


Narrative: _____

Corner Rpt: 65/49-23

DOUGLAS COUNTY
SURVEYOR

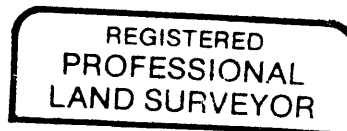

Gary T. Smither

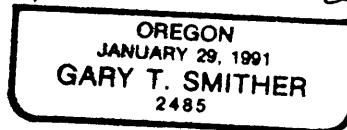

Expires 6/04

314700 - T22-8

300100 - T21-8

Rec'd Feb 2004

C.S. File No 65/49-23