

FILED

Date: 3/22/2004 By: JC

This survey consists of: -

Map: _____

Narrative: _____

Corner Rpt: 65/49-24

OREGON CORNER RESTORATION FORM

Section 36 Township 22S Range 6W

County DOUGLAS Date 2/13/04

Corner Designation

DOUGLAS COUNTY
SURVEYOR

Condition Report Only

Not Found

Renewed

Unrecorded

Surveyed In

Referenced Out

C 1/4

SECTION 36

Previous Renewals/Surveys, etc. LOVE ROCK TIMBER MAP M120-79

Monument(s) & Accessories Found: (Condition and Source)

FOUND 1994 LOVE ROCK TIMBER 2 1/2" ALUMINUM CAP

-- 20" DOUGLAS FIR BEARS S70°38'W 34.36 FEET AS PER RECORD



-- RECORD 10" DOUGLAS FIR S69°35'E 24.69 FEET IS DOWN AND UPROOTED

-- RECORD 12" DOUGLAS FIR S8°14'E 26.79 FEET IS DOWN AND UPROOTED

-- RECORD 13" DOUGLAS FIR N1°35'W 7.6 FEET IS DOWN AND UPROOTED

Monument Detail

Sketch

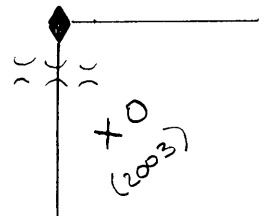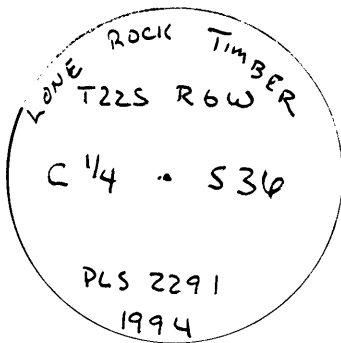

Monument Set (Procedures and Description)

New Accessories

-- 9" DOUGLAS FIR BEARS N85 1/2° E 16.35 FEET WE SCRIBE BT AND TAG TREE

-- 20" DOUGLAS FIR BEARS N9 1/2° E 45.20 FEET WE SCRIBE BT AND TAG TREE

Location & Comments

Surveyor's Seal

CORNER LIES ON SOUTHWEST

Compass Declination 19 1/2°

SCOPE APPROX 40 FEET

Firm/Agency LOVE ROCK

NORTH OF SHALLOW SWALE

TIMBER MANAGEMENT COMPANY



Address P.O. BOX 1127

ROSEBURG, ORE. 97470

Party Chief KEN HOFFINE

Notes GARY ANGIOLLET

Witness IGNACIO ROMAN

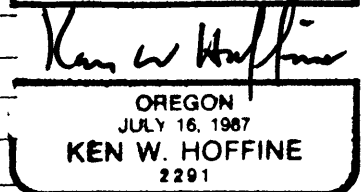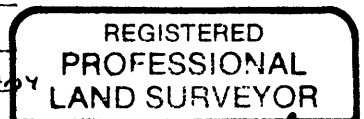

6-30-05

C.S. File No 65/49-24