

FILED

Date: 3/22/04 By: JC

This survey consists of:

Map: \_\_\_\_\_

Narrative: \_\_\_\_\_

Corner Rpt: 65/49-25

OREGON CORNER RESTORATION FORM

Section 36 Township 22S Range 6W

County DOUGLAS Date 2/13/04

Corner Designation

NE 1/16

DOUGLAS COUNTY SURVEYOR

Condition Report Only

Not Found

Renewed

Unrecorded

Surveyed In

Referenced Out

Previous Renewals/Surveys, etc. LOVE ROCK TIMBER MAP M 120-79



Monument(s) & Accessories Found: (Condition and Source)

FOUND 1994 LOVE ROCK TIMBER 2 1/2" ALUMINUM CAP AT GROUND LEVEL

-- 9" DOUGLASS FIR BEAR N26 1/2° E 12.25 AS PER RECORD HEADED FIRE AND TAG

-- 23" OAK AT RECORD S61°25'W 14.57 FT. IS DOWN & UPROOTED

Monument Detail

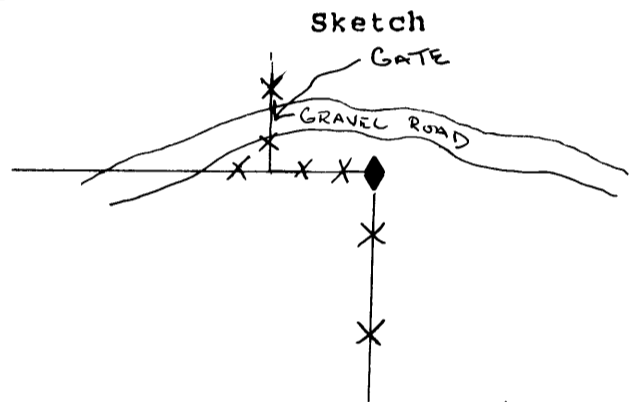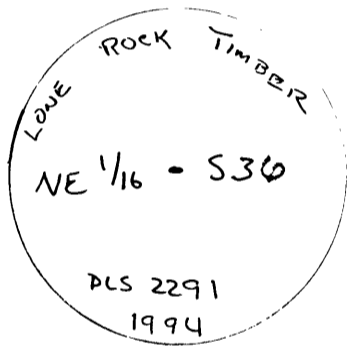

Monument Set (Procedures and Description)

New Accessories

12" OAK BEARS S41°E 12.1 FT WE SCRIBE BT AND TAG TREE

Location & Comments

CORNER LIES ON SOUTHEAST

SLOPE APPROX 23 FT SOUTH

OF GRAVEL ROAD. FENCE

RUNS EAST AND SOUTH FROM

CORNER. CORNER IS 156°E

0.5 FT. FROM BOTTOM OF

FENCE CORNER POST.

Compass Declination 19 1/2°

Firm/Agency LOVE ROCK

TIMBER MANAGEMENT COMPANY

Address P. O. Box 1127

ROSEBUE, OR. 97470

Party Chief KEN HOFFINE

Notes GARY ANGLICK

Witness JONACIO ROMAN

Surveyor's Seal

REGISTERED PROFESSIONAL LAND SURVEYOR

*Ken W Hoffine*

OREGON JULY 16, 1987  
KEN W. HOFFINE  
2291

6-30-05

C.S. File No 65/49-25