

FILED

Date: 3/22/2004 By: JC

This survey consists of:

Map: \_\_\_\_\_

Narrative: \_\_\_\_\_


Corner Rpt: 65/49-26

OREGON CORNER RESTORATION FORM

Section 22 Township 32S Range 6W

County DOUGLAS Date 1/13/04

Corner Designation

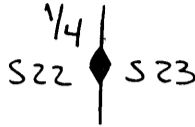

DOUGLAS COUNTY SURVEYOR

- Condition Report Only
- Not Found
- Renewed
- Unrecorded
- Surveyed In
- Referenced Out

Previous Renewals/Surveys, etc. ORIGINAL GLO SURVEY (DCSO RECORDS Vol 20 PAGE 8671), 1977 SURVEY BY BRAUNT CS FILE 58/125 AND MAP M 69-3


Monument(s) & Accessories Found: (Condition and Source)

- FOUND 1" PIPE OUTSIDE DIAMETER IN MOUND OF large STONES
- FOUND ORIGINAL BLACK OAK REMAINS AND STUMP HOLE S84°E APPROX 12 FEET (RECORD S84°E 11.88 FEET)
- LOOK FOR ORIGINAL BLACK OAK AT RECORD N39°W 34.25 FEET. THIS BEARING & DISTANCE FALLS IN OLD SKID ROAD, NO STUMP REMAINS, BUT REMAINS OF BURNED LARGE DOWN BLACK OAK STEM and limbs on ground fallen TO THE WEST

Monument Detail

WGS 1984  
42° 46' 32.3" N  
123° 23' 14.0" W

Sketch

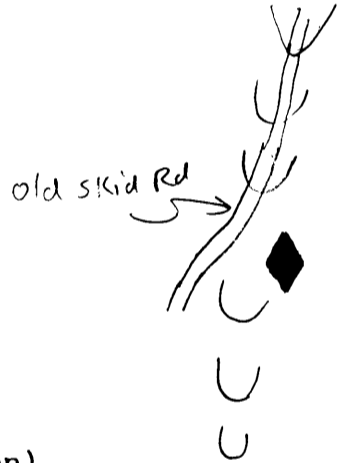

Monument Set (Procedures and Description)

N/A

New Accessories

- 7" MADRONA IN CLUMP OF 2 TREES BEARS S78°E 9.1' I BARK SCRIBE 1/4 S23 BT AND TAG
- 11" DOUGLAS FIR BEARS S49°W 17.1' FEET I SCRIBE 1/4 S22 BT AND TAG
- 13" DOUGLAS FIR BEARS N43°W 16.7' FEET I SCRIBE 1/4 S22 BT AND TAG
- 11" DOUGLAS FIR BEARS N47°E 26.8' FEET I SCRIBE 1/4 S23 BT AND TAG

Location & Comments

Corner Lies 19 FEET Compass Declination 19 1/2°  
ABOVE GROUND ON Firm/Agency LOVE ROCK  
NORTH-SOUTH RIDGETOP Timber Company  
OLD SKID ROAD APPROX 30 Address P.O. Box 1127  
FT WEST OF CORNER ROSEBURG, OR 97470  
 Party Chief KEN HOFFINE  
 Notes KEN HOFFINE  
 Witness \_\_\_\_\_

Surveyor's Seal

REGISTERED PROFESSIONAL LAND SURVEYOR

Ken W Hoffine  
OREGON  
JULY 18, 1987  
KEN W. HOFFINE  
2291

6-30-05

C.S. File No 65/49-26