

Date 4/19/04

GOVERNMENT CORNER RESTORATION FORM

Filed

Date: 4/30/2004 By: JS
This survey consists of:

Township 25S Range 3W Corner NW/4 PLSS # Sec 27

Map: _____

Geographic Location - south zone

Narrative: _____

Corner Rpt: 65/49-27

DOUGLAS COUNTY
SURVEYOR

N: _____ E: _____

Lat: 1 Long: _____

Datum/Adj.: _____ Precision: _____ File # _____ Date: _____ Agency: _____

Previous Renewals _____

Monument(s) Found (Condition and source):

1943 7 1/2" BC ON IRON POST UP 0.6' WITH STEEL FENCE POST ALONGSIDE
GOOD CONDITION

Accessories Found:

32" HEMLOCK BT S 55° E 18.5' ROTTING STUMP
30" NOW 24" FIR STUMP BT N 29 3/4° E, 26.4' 5' TALL. NO BARK SCRIBE VIS.
TAG.
32" FIR BT N 24° W, 8.58' NOW LOW ROTTED STUMP APPROX. 20" IN DIA.
7" NOW 16" HEMLOCK BT, N 60° E, 13.8' SCRIBE VIS, DOUBLE BLAZE, TAG
8" NOW 22" HEMLOCK BT S 78° E, 58.5' SCAR VIS, WITH TAG
5" NOW 8" HEMLOCK BT, N 73° E, 42.1' SCRIBE VIS, DOUBLE BLAZE
N 73° W


Monument Set (Procedure and Description):

NONE

New Accessories:

NONE

Sketch, Detail, or Location

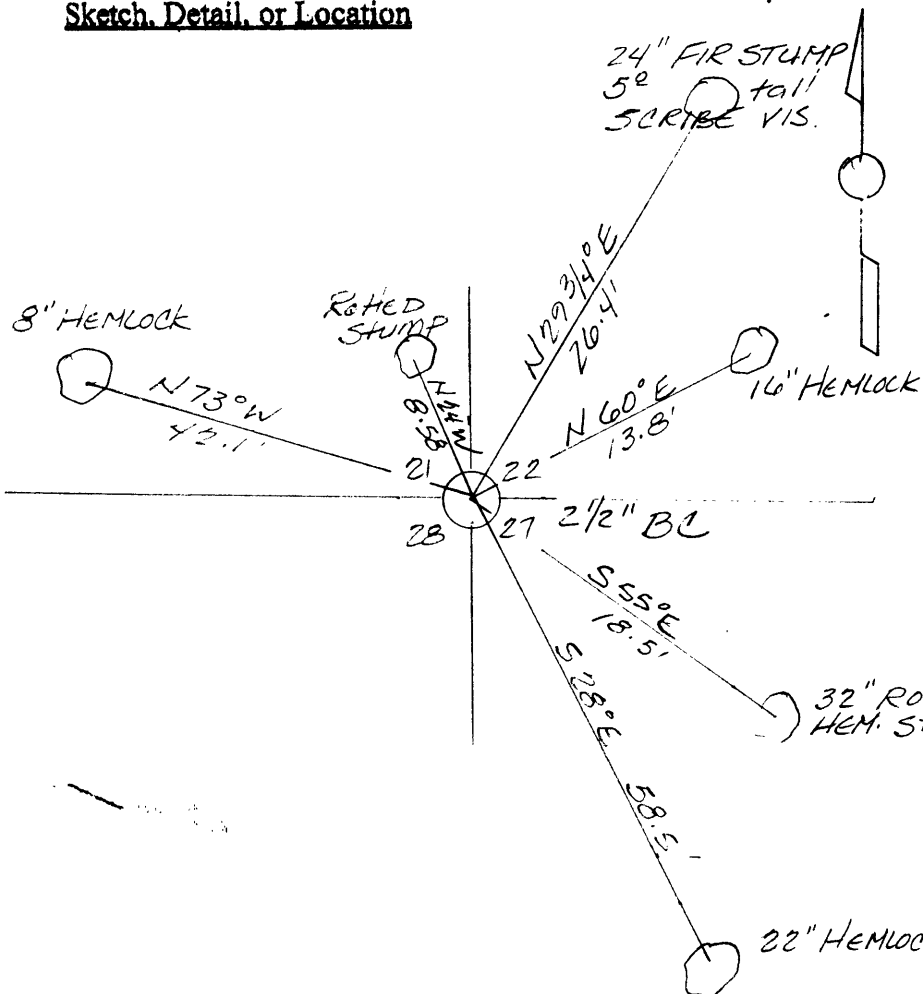

Location & Comments

Compass Declin. 19 1/2° E
Crew C. Sweeden
R. Merck
Sweeden Land Surveying
5211 Cole Rd. Oakland OR
Surveyor's Seal & exp. date. 97462



C.S. File No 65/49-27