

Date 4/19/04

GOVERNMENT CORNER RESTORATION FORM

Filed

Date: 4/30/04 By: X
This survey consists of:

Township 25S Range 3W Corner. N¹/₄ PLSS # SEC. 28

Map: _____

Geographic Location - south zone

Narrative: _____

Corner Rpt: 65/49-28

DOUGLAS COUNTY
SURVEYOR

N: _____ E: _____

Lat: 1 _____ Long: _____

Datum/Adj.: _____ Precision: _____ File # _____ Date: _____ Agency: _____

Previous Renewals _____

Monument(s) Found (Condition and source):

1943 2 1/2" BC ON IRON POST, UP 0.8', AT BOTTOM OF 50-60' VERT. ROCK WALL
GOOD CONDITION

Accessories Found:


40" D. FIR BT, N 49°E, 9.24' HEALED DBL BLAZE, STAR VIS TAG
26" NOW 31" D. FIR BT, S 80°W, 32.34', DOUBLE BLAZED, STAR VIS, TAG

Monument Set (Procedure and Description):

New Accessories:

14" HEMLOCK BT, N 40°W, 26.83', SCRIBED "S 1/4 S 21 BT" AND BT TAGGED

Sketch, Detail, or Location

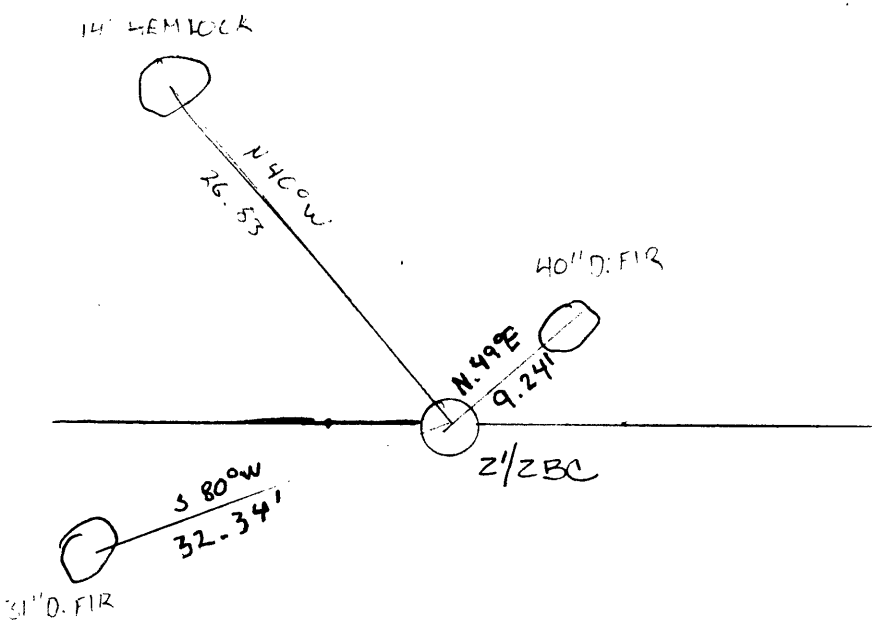

Location & Comments

CORNER LOCATED APPROX.
6' No. of 50'-60' Vert.
Wall

Compass Declin. 19 1/2° E.

Crew C. Sweeden & R. Mercer
Sweeden Land Surveying
5211 Cole Rd.

Oakland, OR. 97462

Surveyor's Seal & exp. date.

REGISTERED
PROFESSIONAL
LAND SURVEYOR

Carl A. Sweeden
OREGON
CARL A. SWEEDEN
2752
JAN. 16, 1986

Exp. 6/30/04

C.S. File No 65/49-28