

FILED

Date: 5/3/2004 By: JC

This survey consists of:

Map: \_\_\_\_\_

Narrative: \_\_\_\_\_

Corner Rpt: 65/49-32

OREGON CORNER RESTORATION FORM

Section 24 Township 30S Range 8W

County DOUGLAS Date 5-3-04

DOUGLAS COUNTY  
SURVEYOR

Corner Designation

$\frac{1}{4}$   $\frac{24}{25}$

Condition Report Only

Not Found

Renewed

Unrecorded

Surveyed In

Referenced Out

Previous Renewals/Surveys, etc.

SEE RENEWAL #28 BY RSRG.LDM. IN 1962 & BLM SURVEY & LINE NOTES IN 1985

Monument(s) & Accessories Found: (Condition and Source)


FOUND 2 1/2" BRASS CAP SET BY BLM

A 20" D. FIR BEARS N 74 1/2° E 13.86' HEALED


A 13" W. FIR BEARS S 40 1/2° W 85.8' HEALED

(BOTH B.T.S BY BLM IN 1985)

Monument Detail

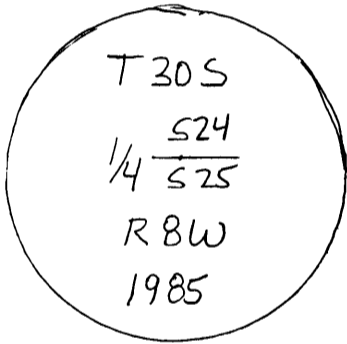

Sketch

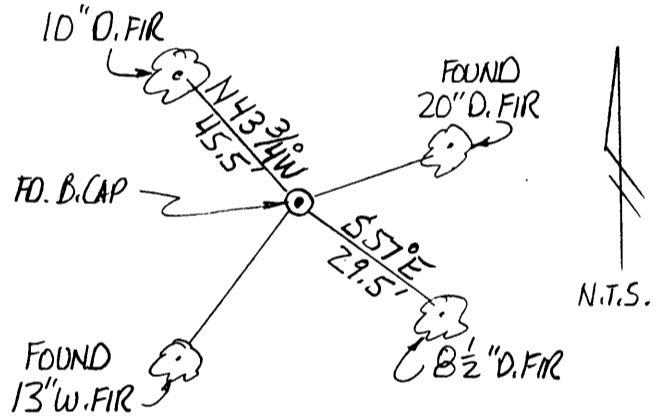

Monument Set (Procedures and Description)

N/A

New Accessories

8 1/2" D. FIR BEARS S 57° E 29.5' SCRIBED "1/4 S 25 BT"

10" D. FIR BEARS N 43 3/4° W 45.5' SCRIBED "1/4 S 24 BT"

Location & Comments

CORNER LIES ON NORTHERLY SLOPE ON THE WESTERLY SIDE OF A DRAINAGE & SOUTH OF OLD SHED RD.

Compass Declination N/A

Firm/Agency \_\_\_\_\_

GREGORY D. LANG

Address 7550 WILLIS CR. RD.

WINSTON, OR. 97496

Party Chief GREGORY LANG

Notes SAME

Witness TREVOR LANG

Surveyor's Seal



EXPIRES 12-31-04

C.S. File No 65/49-32