

Date 6/07/04

GOVERNMENT CORNER RESTORATION FORM

Filed

Date: 6/10/2004 By: JC  
This survey consists of:

Township 32.5 Range 6W Corner. SWCOR PLSS # SEC. 7

Map: \_\_\_\_\_

Geographic Location - south zone

Narrative: \_\_\_\_\_

Corner Rpt: 65/49-42

N: \_\_\_\_\_ E: \_\_\_\_\_

DOUGLAS COUNTY  
SURVEYOR

Lat: 1 Long: \_\_\_\_\_

Datum/Adj.: \_\_\_\_\_ Precision: \_\_\_\_\_ File # \_\_\_\_\_ Date: \_\_\_\_\_ Agency: \_\_\_\_\_

Previous Renewals \_\_\_\_\_

Monument(s) Found (Condition and source):

1965 2 1/2" DCSO BC, UP 1.6' LEANING NORTH IN ROCK MOUND, RESET VERTICAL

Accessories Found:

ROOT HOLE, S 8° E 11.9' REMAINS OF ROTTING 40" FIR ON GROUND  
33" D. FIR BT, N 63° W 46.86', HEALED DBL BLAZE, TAG  
13" FIR SNAG BT, N 72° E 91.6', SCRIBE VIS. ON DBL BLAZE, TAG  
35" D. FIR BT, S 85° E 38.6', TAG, SCAR FROM HEALED DBL BLAZE  
10" D. FIR BT, S 76° W 56.3' (57.75'), HEALED DBL BLAZE, TAG.  
53" D. FIR BT, N 69 1/2° E 63.36, BARK SCRIBE VIS. IN DBL BLAZE, TAG


Monument Set (Procedure and Description):

New Accessories:

DRIVE STEEL "U" POST 1.0' EAST

Sketch, Detail, or Location

Location & Comments

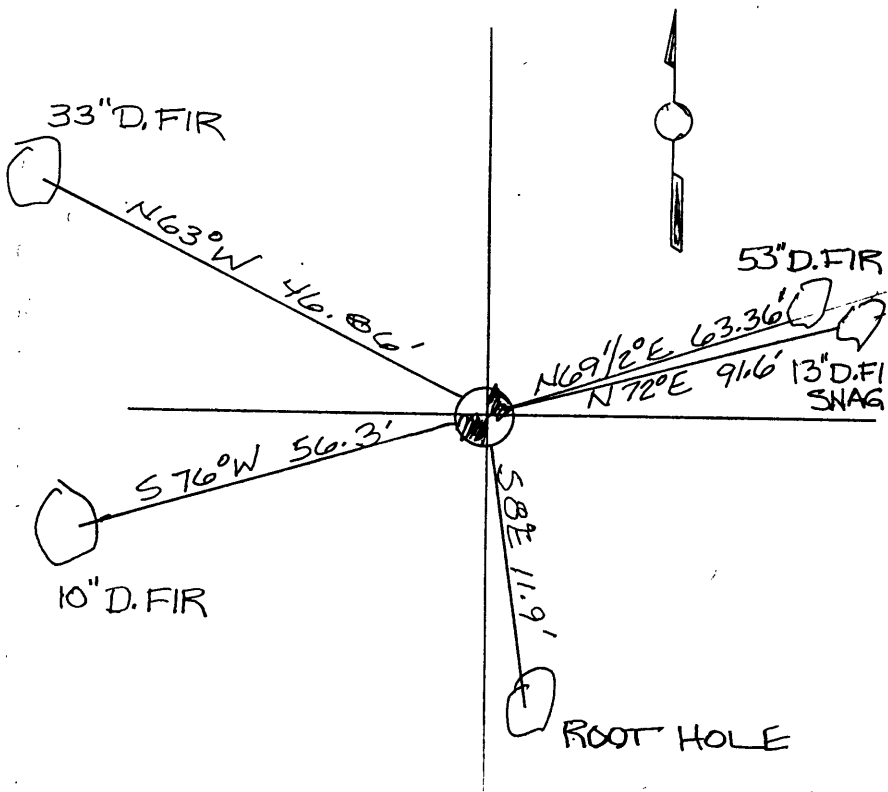

Compass Declin. 19 1/2° EAST  
Crew C. SWEEDEN, R. MERLER  
SWEEDEN LAND SURVEYING  
558 SE. JACKSON ST.  
ROSEBURG, OR 97470  
Surveyor's Seal & exp. date.



100500

C.S. File No 65/49-42 Exp 6/30/04