


EXHIBIT "A"

LOT 4, PLAT B
 DEER CREEK ORCHARD TRACTS
 ROSEBURG SAND & GRAVEL CO.
 INST. NO. 93-24290
 (VOL. 153, PAGE 666)

LOT 5

LOT 3

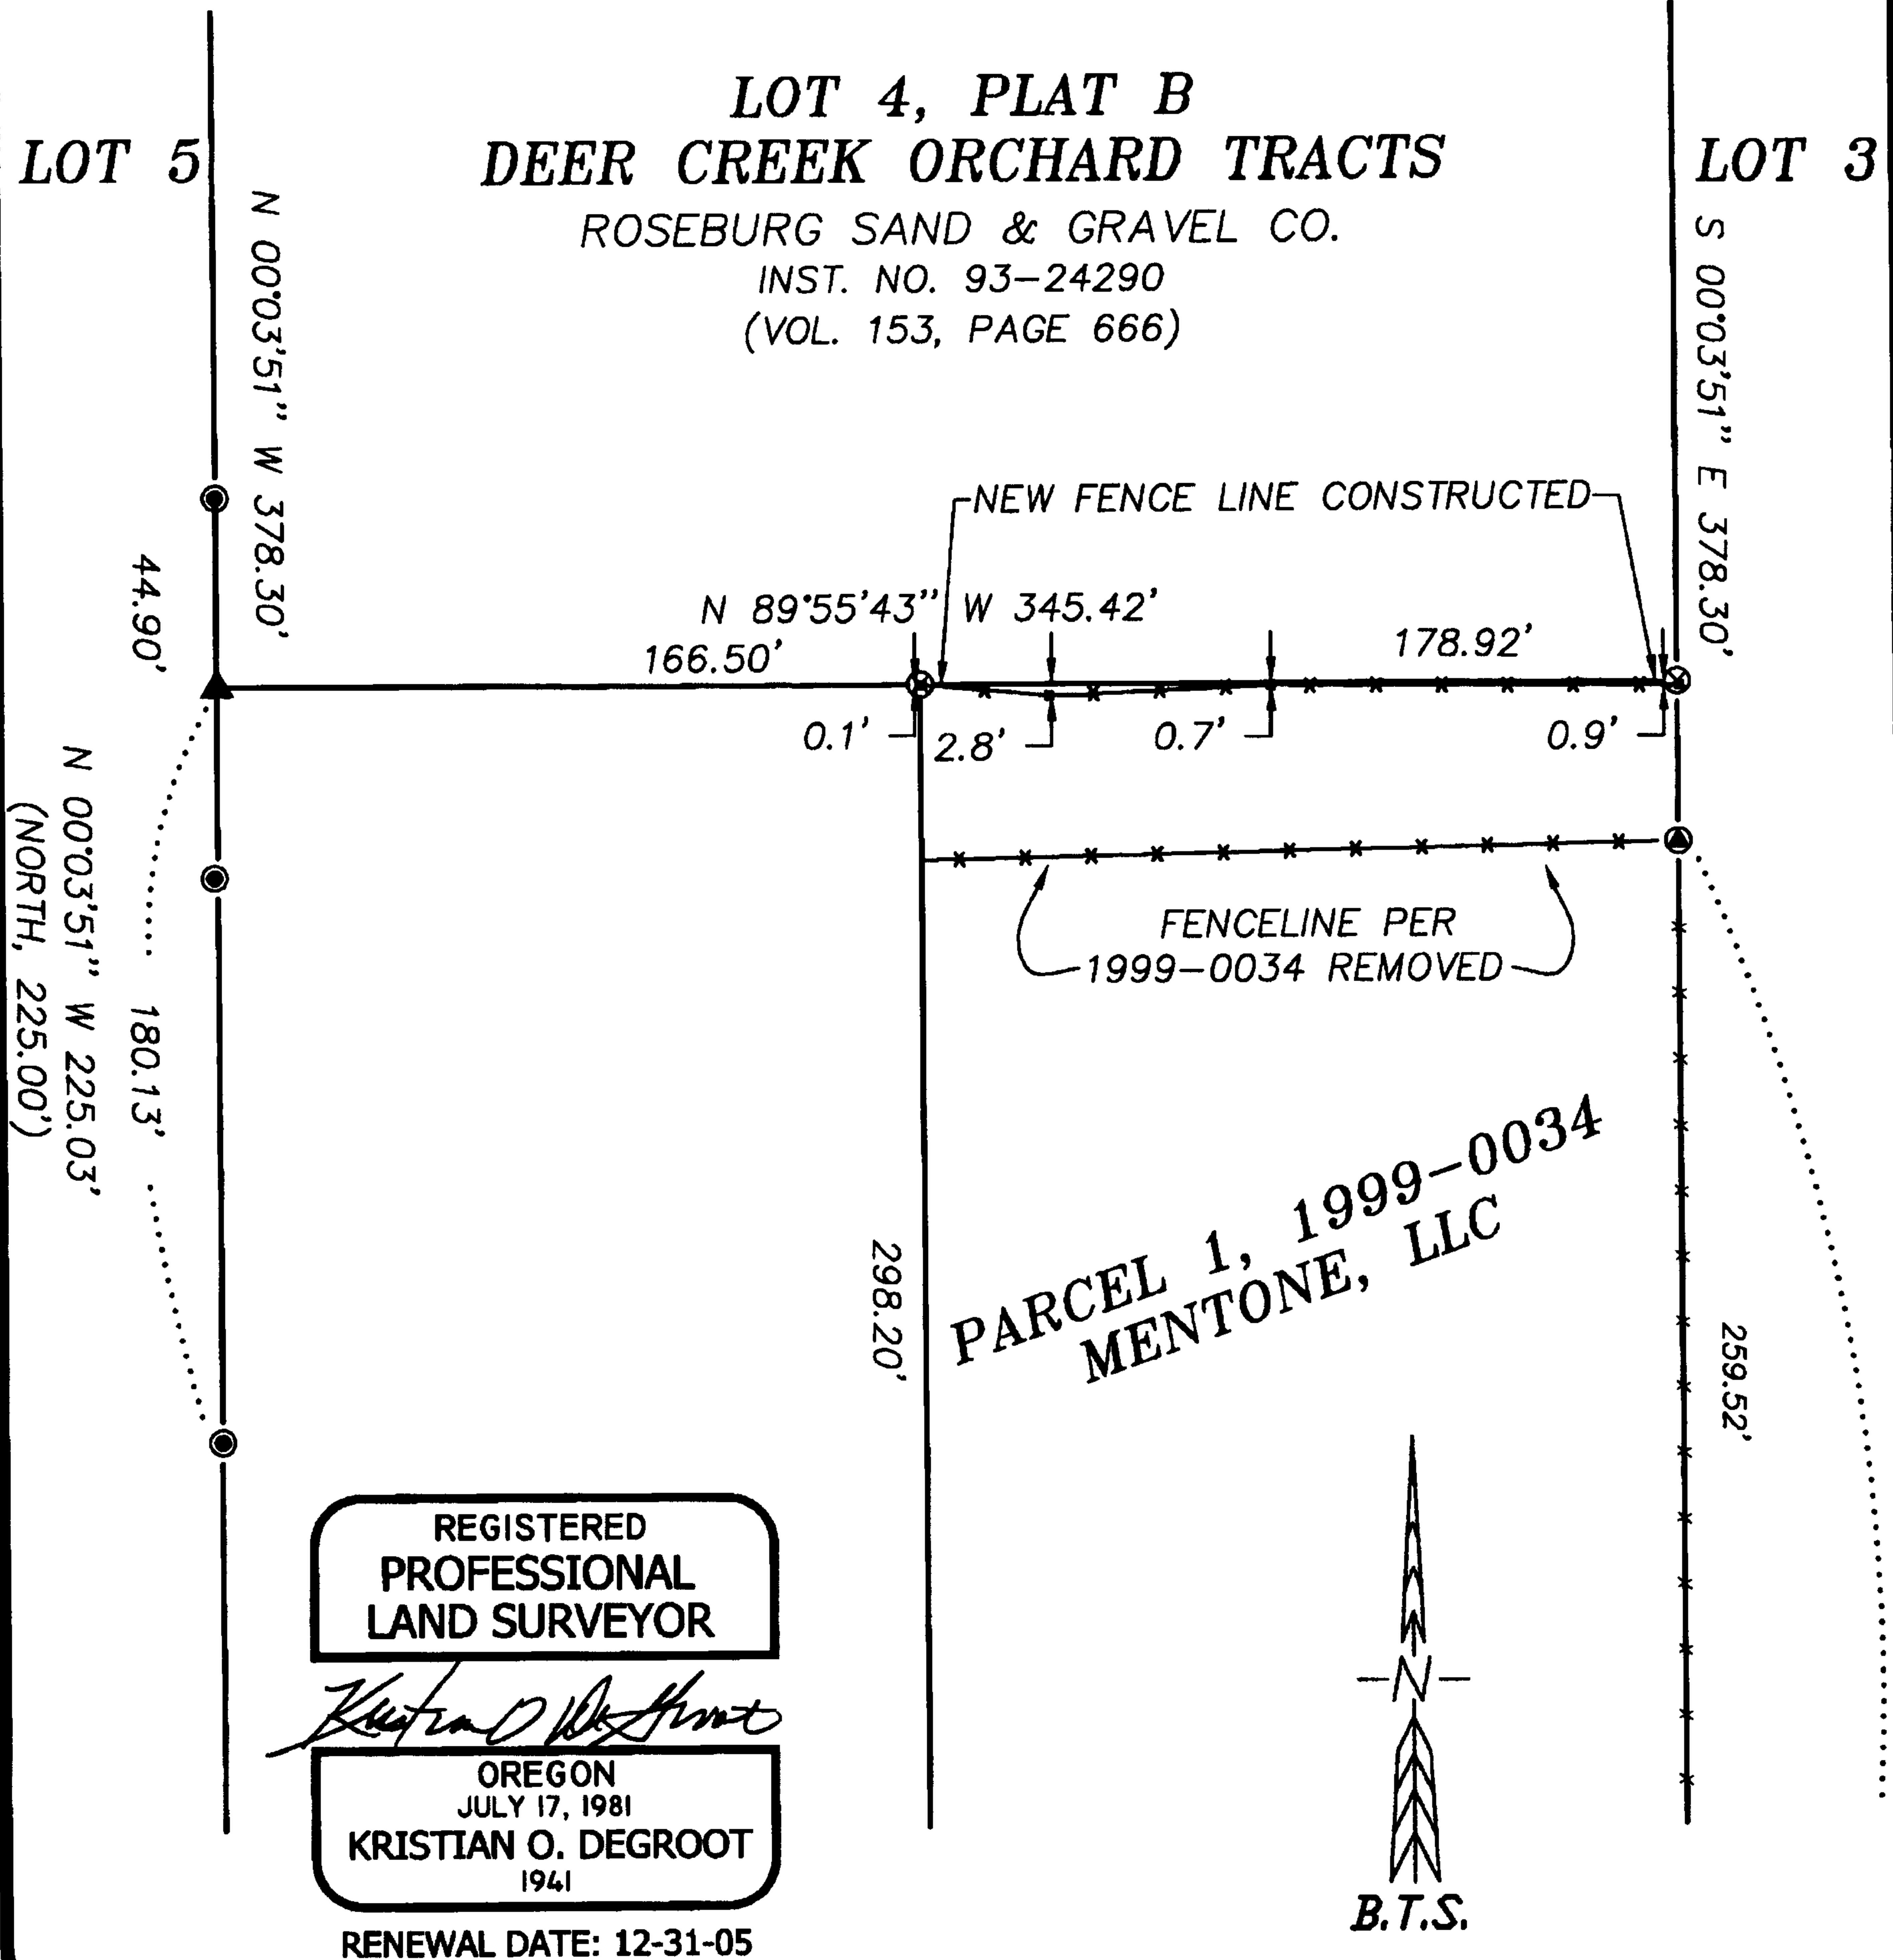

REGISTERED
 PROFESSIONAL
 LAND SURVEYOR

Kristian O. Degroot

OREGON
 JULY 17, 1981
 KRISTIAN O. DEGROOT
 1941

RENEWAL DATE: 12-31-05

NEW FENCE LINE CONSTRUCTED

FENCE LINE PER
 1999-0034 REMOVED

PARCEL 1, 1999-0034
 MENTONE, LLC



DATE: DEC. 17, 2003	LAND PARTITION PLAT 1999-0034	FOR:
PROJ. #: 03-098		MENTONE L.L.C.
SCALE: 1" = 60'	FENCE LINE RESURVEY	BTS ENGINEERING & SURVEYING, INC. 431 S.E. MAIN ST., ROSEBURG, OR 97470 PHONE (541) 673-0966 FAX (541) 673-0105

END OF DOCUMENT

C.S. File No 65/50-2 B