

FILED

Date: 8-4-2004 By: JC

Form 771 10/95 OMR
This survey consists of:

PUBLIC LAND CORNER

INDEX NO. _____


M
N
C

65/52-1A-B

WEYERHAEUSER COMPANY

DOUGLAS COUNTY
SURVEYOR

WILLAMETTE REGION

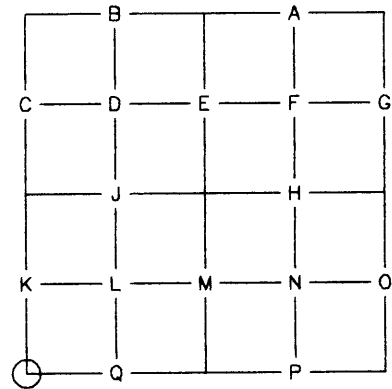

TOWNSHIP 23 SOUTH RANGE 1 WEST

SECTION 30 CORNER SW

COUNTY DOUGLAS OREGON

ORIGINAL CORNER DATED: 1883 BY: GLO - McQUINN

CORNER: POST

ACCESSORIES: 6" FIR, N 32 E, 26 LKS.

20" FIR, S 45 E, 52 LKS.

20" FIR, S 38 W, 7 LKS.

24" FIR, N 57 W, 31 LKS.

SUPERSEDED BY CHANDLER

RE-ESTABLISHMENT NOTES DATED: 1893 BY: GLO - CHANDLER

CORNER SET: DESTROYS 1883 McQUINN CORNER AND SETS POST

ACCESSORIES ESTABLISHED: 20" CEDAR, N 16 E, 36 LKS.

30" FIR, S 56 E, 17 LKS.

20" CEDAR, S 72 W, 58 LKS.

20" FIR, N 65 W, 37 LKS.

RE-ESTABLISHMENT NOTES DATED: 1962 BY: GEORGIA PACIFIC

EVIDENCE RECOVERED: 40" FIR, S 56 E, 11.2 FEET - BLM TAG ON OBT

CORNER SET: 1-1/2" IRON PIPE

ACCESSORIES ESTABLISHED: 28" HEMLOCK, N 55 E, 36.2 FEET - GP TAG

60" FIR, S 65 W, 28.8 FEET - GP TAG

32" FIR, N 40 W, 27.7 FEET - GP TAG

RE-ESTABLISHMENT NOTES DATED: 1964 BY: BLM - GLENN

EVIDENCE RECOVERED: 2" IRON PIPE

32" CEDAR STUMP, N 16 E, 36 LKS. - BURNED - OBT

30" HEMLOCK STUMP, N 45-1/2 E, 57 LKS. - CLOSED BLAZE

40" FIR, S 56 E, 17 LKS. - BARK SCRIBING VISIBLE - OBT

60" FIR, S 62-1/4 W, 46 LKS. - SCRIBING VISIBLE

30" CEDAR SNAG, S 72 W, 58 LKS. - OPEN BLAZE, BURNED - OBT

CORNER SET: 2-1/2"x28" IRON PIPE WITH BLM BRASS CAP DATED 1964

ACCESSORIES ESTABLISHED: 35" FIR STUMP, N 56 E, 74 LKS. - SCRIBED "T23S R1W S30 BT"

36" FIR STUMP, N 43-1/2 W, 44 LKS. - SCRIBED "T23S R2W S25 BT"

REMONUMENTATION

DATE: 7/8/04 BY: DAVID WELLMAN TITLE: PLS 2163 FIRM: D. WELLMAN SURVEYING

EVIDENCE RECOVERED: 2-1/2" IRON PIPE WITH BLM BRASS CAP DATED 1964, 0.7 AGL

32" CEDAR STUMP, 1964 BLM TAG READS "S 16 W, 36 LKS." - OBT

40" FIR STUMP, 1986 BLM TAG READS "N 56 W, 17 LKS." - TIN CAP - OBT

35" FIR STUMP, 1964 BLM TAG READS "S 56 W, 74 LKS." - SCRIBING VISIBLE

36" FIR STUMP, 1964 BLM TAG READS "S 43-1/2 E, 44 LKS." - SCRIBING VISIBLE

8" FIR, 2000 WEYCO TAG READS "N 21 E, 6.7 FEET" TO "W" NAIL - OPEN FACE

9" FIR, 2000 WEYCO TAG READS "S 33 E, 7.7 FEET" TO "W" NAIL - OPEN FACE

9" FIR, 2000 WEYCO TAG READS "S 25 W, 15.3 FEET" TO "W" NAIL - OPEN FACE

OTHER INFORMATION: 6' METAL FENCE POST SET 1.0 FOOT NORTH

