

FILED

Date: 8/5/2004 By: JE

This survey consists of:


PUBLIC LAND CORNER

INDEX NO. \_\_\_\_\_

Map No. \_\_\_\_\_

Corner 65/52-3 A & B

**DOUGLAS COUNTY**  
**WEYERHAEUSER COMPANY**  
**SURVEYOR** **WILLAMETTE REGION**

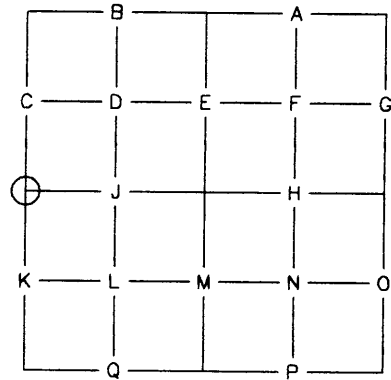

TOWNSHIP 23 SOUTH RANGE 1 WEST  
SECTION 31 CORNER W 1/4  
COUNTY DOUGLAS OREGON

ORIGINAL CORNER DATED: 1883 BY: GLO - McQUINN  
CORNER: POST

ACCESSORIES: 18" FIR, S 87 W, 23 LKS.  
24" CEDAR, EAST, 58 LKS.  
\*SUPERSEDED BY CHANDLER\*

RE-ESTABLISHMENT NOTES DATED: 1893 BY: GLO - CHANDLER  
EVIDENCE RECOVERED: NO EVIDENCE FOUND

CORNER SET: STONE 18"x8"x6" MARKED "1/4" ON WEST FACE  
ACCESSORIES ESTABLISHED: 18" CEDAR, S 18 E, 50 LKS.  
24" FIR, N 61 W, 25 LKS.

RE-ESTABLISHMENT NOTES DATED: 1964 BY: BLM - GLENN  
EVIDENCE RECOVERED: NO EVIDENCE OF ORIGINAL CORNER  
CORNER SET: 2-1/2"x24" IRON PIPE WITH BLM BRASS CAP DATED 1964  
ACCESSORIES ESTABLISHED: 48" FIR, S 44-1/2 E, 31 LKS. - SCRIBED "1/4 S31 BT"  
36" FIR, S 53 W, 78 LKS. - SCRIBED "1/4 S36 BT"

RE-ESTABLISHMENT NOTES DATED: 1978 BY: WEYCO - McCHESNEY  
EVIDENCE RECOVERED: 2-1/2"x28" IRON PIPE WITH BLM BRASS CAP DATED 1964  
DOWN 36" FIR, S 44 E, 20.5 FEET TO CENTER OF ROOT HOLE  
36" FIR, S 55 W, 51.7 FEET TO CENTER OF TREE - BLM TAG & HEALED FACE  
ACCESSORIES ESTABLISHED: 40" FIR, N 69 E, 8.3 FEET TO "W" NAIL - WEYCO TAG  
18" HEMLOCK, S 61 W, 3.8 FEET TO "W" NAIL - WEYCO TAG  
32" RED CEDAR STUMP, N 78 W, 50.8 FEET TO "W" NAIL - WEYCO TAG

REMONUMENTATION

DATE: 7/8/04 BY: DAVID WELLMAN TITLE: PLS 2163 FIRM: D. WELLMAN SURVEYING  
EVIDENCE RECOVERED: 2-1/2"x28" IRON PIPE WITH BLM BRASS CAP DATED 1964, 0.5 AGL  
40" FIR SNAG, WEYCO TAG READS "S 69 W, 8.3 FEET" TO "W" NAIL  
18" HEMLOCK STUMP, WEYCO TAG READS "N 61 E, 3.8 FEET" TO "W" NAIL - ROTTEN  
32" RED CEDAR STUMP, WEYCO TAG READS "S 78 E, 50.8 FEET" TO "W" NAIL

ACCESSORIES ESTABLISHED: 10" CEDAR, S 13-1/2 E, 21.7 FEET TO SPIKE SET SIDE CENTER - SCRIBED "W1/4 S31 BT"

OTHER INFORMATION: 6' METAL FENCE POST SET 1.0 FOOT SOUTH

