

OREGON CORNER RESTORATION FORM

FILED

Date: 11-24-2004 By: JC
 of:
4145-71
65/52-16 AC

Section: 16 Township: 30S Range: 03W

County: Douglas Date: 10-12-04

Corner Designation

1/4 $\frac{S9}{S16}$

- Condition Report Only
- Not Found
- Renewed
- Unrecorded
- Surveyed In
- Referenced Out

DOUGLAS COUNTY
SURVEYOR


Previous Renewals / Surveys, etc.:

GLO in 1893 by Bushey; Original was remonumented by Douglas County in 1966 per C.S. file 54/52.


Monument (s) & Accessories Found: (Condition & Source)

- Found DCSO Brass cap
- 18" D. Fir bears N64 1/2*E 8.7' (1966 by DCSO)
- 9 1/2" Madrone bears S83 1/2*E 24.0' (1966 by DCSO)
- 40" Fir stump bears N36*W 9.6' (original)
- 12" Fir stump bears S29*W 27.7' (original)

Monument Detail:

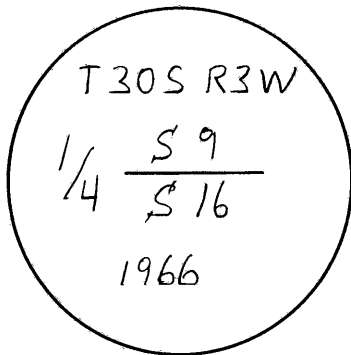

Sketch:

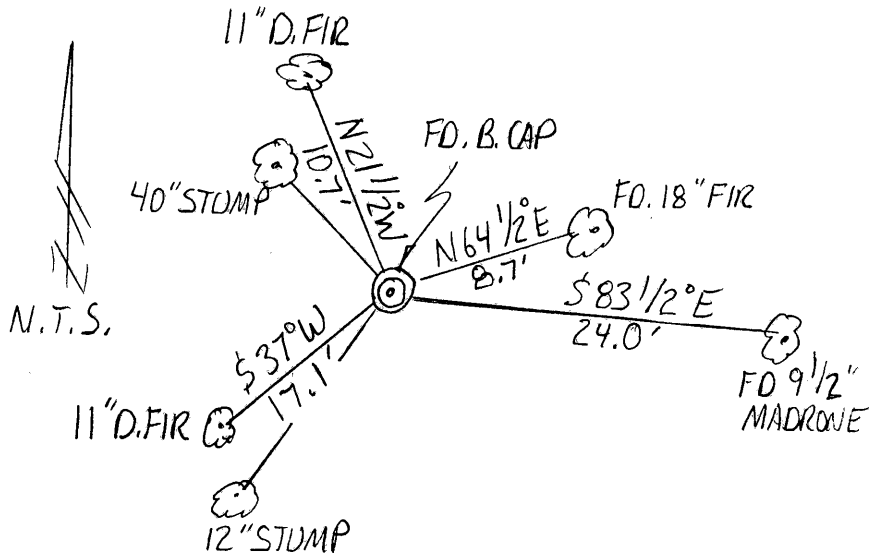

Monument Set (Procedures and Description)

N/A

New Accessories

- 11" D. Fir bears N21 1/2*W 10.7' scribed "1/4 S9 BT"
- 11" D. Fir bears S37*W 17.1' scribed "1/4 S16 BT"

NOTE: We set and measured to spikes in the base of all bearing trees; bearings to the trees are based on BLM's 1972 survey line from the N1/4 Corner to the NW Section Corner of Section 21 (S89*41'00"W).

Location & Comments

Corner lies on a southerly slope; approx. 20' south of a dirt road.

Compass Declination: N/A

Firm/Agency:

Gregory D. Lang, Surveyor
 Address: 7550 Willis Cr. Rd.
 Winston, Oregon 97496

Party Chief: Gregory Lang

Notes: Same

Witness: Trevor Lang

Surveyor's Seal



EXPIRES 12-31-2004

C.S. File No 65/52-16 B