

FILED

Date: 9-18-2007 By: JC

This survey consists of:

Map: \_\_\_\_\_

Narrative: \_\_\_\_\_

Corner Rpt: 65/52-23

DOUGLAS COUNTY  
CLERK

**OREGON CORNER RESTORATION FORM**

Section 23 Township 26 S Range 8 W

County DOUGLAS Date 8/30/2007

Corner Designation

SW 1/16 Section 23

- Condition Report Only
- Not Found
- Renewed
- Unrecorded
- Surveyed In
- Referenced Out

Previous Renewals/Surveys, etc. Robert C. Adameck Aug. 18 1975 M57-74

Monument(s) & Accessories Found: (Condition and Source)

Found 3/4" Iron Pipe in good condition 0.5 feet above ground on a steep North facing slope


Found a 21" DF stump N 75°W 2.8 feet. Found a 23" DF stump N44°28'E 28.04 feet

Monument Detail

BLAZED PAINTED TAGGED  
LRT MEASURED  
RECORD MEASURED

//////  
<LRT 2007>  
(ADAMEK 1975)

Sketch

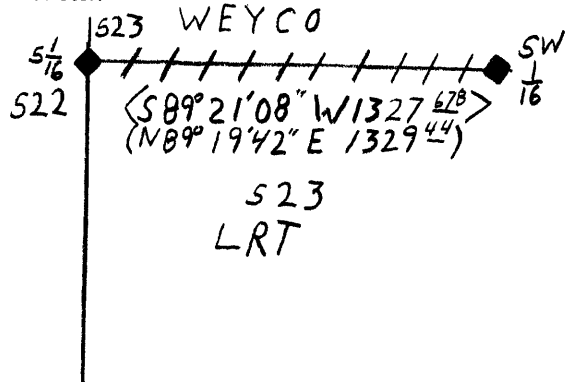

Monument Set (Procedures and Description)

New Accessories

New BT

10" Douglas Fir S64°48' W 22.18 feet. Scribed SW1/16 S 23 BT and Tagged Tree.

13" Douglas Fir S46°46' E 24.91 feet. Scribed SW 1/16 S23 BT and Tagged Tree

Location & Comments

|                               |                          |                         |
|-------------------------------|--------------------------|-------------------------|
| <u>Found a 3/4" Iron Pipe</u> | <u>Basis of Bearing</u>  | <u>Solar</u>            |
| <u>in good condition</u>      | <u>Firm/Agency</u>       | <u>Lone Rock Timber</u> |
| <u>0.6 feet above ground</u>  | <u>Management Co.</u>    |                         |
| <u>on steep North facing</u>  | <u>Address</u>           | <u>PO BOX 1127</u>      |
| <u>slope</u>                  | <u>Roseburg OR 97470</u> |                         |
|                               | <u>Party Chief</u>       | <u>Ken Hoffine</u>      |
|                               | <u>Notes</u>             | <u>Jason Moon</u>       |
|                               | <u>Witness</u>           | <u>Ignacio Roman</u>    |

Surveyor's Seal

REGISTERED  
PROFESSIONAL  
LAND SURVEYOR

*Ken W Hoffine*

OREGON  
JULY 16, 1997  
KEN W. HOFFINE  
2291

Expires 6-30-09

C.S. File no 65/52-23