

FILED

Date: 2-14-2005 By: JC

This survey consists of:

Map: _____

Name: _____

Corner Rpt: 65/54-5

DOUGLAS COUNTY
SURVEYOR

OREGON CORNER RESTORATION FORM

Section 36 Township 29S Range 7W

County DOUGLAS Date 1-7-05

Corner Designation
CENTER SOUTH 1/16

- Condition Report Only
- Not Found
- Renewed
- Unrecorded
- Surveyed In
- Referenced Out

Previous Renewals/Surveys, etc. M93-45

Monument(s) & Accessories Found: (Condition and Source)

1982 3 1/2" DIA ALUMINUM CAP MARKED LS 1101


19" FIR N25E 34 HEALED

17" W. FIR N30W 39E HEALED

4x4 WITNESS POST N44W 28 SOLID

Monument Detail

Sketch

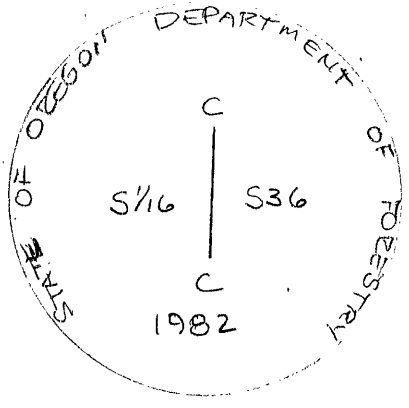


Monument Set (Procedures and Description)

New Accessories

Location & Comments

Surveyor's Seal

Compass Declination 19°
 Firm/Agency ROSEBURG RESOURCES COMPANY
 Address PO Box 1088 ROSEBURG OREGON 97470
 Party Chief Bill Olson
 Notes _____
 Witness KEN COBLE

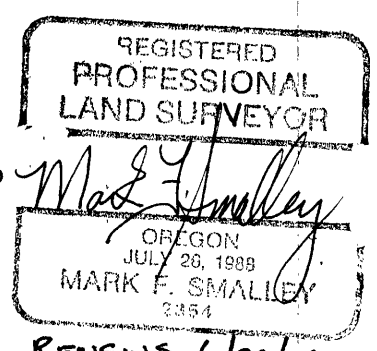

RENEWS 6/30/06

C.S. File No 65/54-5