

FILED

Date: 2-14-2005 by: SC

Title: _____ of:

Map: _____

Acres: _____

Corner Post: 65/54-6

DOUGLAS COUNTY
SURVEYOR

OREGON CORNER RESTORATION FORM

Section 36 Township 29S Range 7W

County DOUGLAS Date 1-7-05

Corner Designation

SOUTH EAST 1/16

- Condition Report Only
- Not Found
- Renewed
- Unrecorded
- Surveyed In
- Referenced Out

Previous Renewals/Surveys, etc. M93-45

Monument(s) & Accessories Found: (Condition and Source)

1982 3 1/2" DIA ALUMINUM CAP MARKED LS 1101 LYING ON THE GROUND



18" J. PINE STUMP SPO 1/2 E 6' SCRIBE VISIBLE

19" FIR STUMP S2W 29' SCRIBE VISIBLE

4x4 WITNESS POST ROTTEN AT GROUND LEVEL N66W 2'

Monument Detail

Sketch

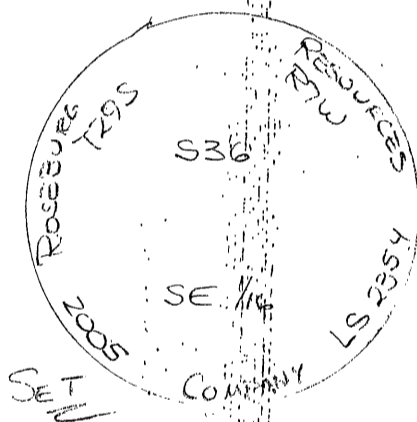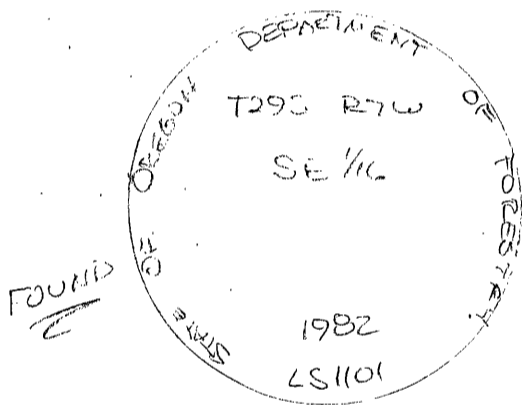

Monument Set (Procedures and Description)

3/8" x 48" I.R. ALUMINUM CAP

MEASURING HORIZONTAL DISTANCES FROM THE NAILS IN THE CENTER OF THE TWO STUMPS, 6' FROM THE PINE, AND 29' FROM THE FIR STUMP RESET THE SE 1/16 CORNER

New Accessories

BTs: 16" FIR N74W 13' SCRIBED "SE 1/16 BT"

11" FIR S24E 17' SCRIBED "SE 1/16 BT"

Location & Comments

1982 Monument was out of the ground and bent.

Compass Declination 19°

Firm/Agency ROSEBURG

RESOURCES COMPANY

Address PO Box 1088

ROSEBURG OREGON 97470

Party Chief Bill Olson

Notes _____

Witness KEN COBLE

Surveyor's Seal

REGISTERED
PROFESSIONAL
LAND SURVEYOR

Mark F. Smalley
OREGON
JULY 29, 1988
MARK F. SMALLEY
2354

RENEWS 6/30/06

C.S. File No 65/54-6