

FILED

Date: 2/18/2005 By: SC

This survey consists of:

Map: _____

Next file: _____

Corner Rpt: 65/54-7

DOUGLAS COUNTY
SURVEYOR

**Township 21 South, Range 8 West
Section 8**

Corner Report February, 2005

Southeast Corner for Section 8: Found 1945 Brass Cap on Iron Pipe firmly set with a steel fence post driven alongside the Brass Cap.

Old Bearing Trees:

70" Fir stump, N 84 ½ ° E, 24.4 feet (record 37 links), burnt and rotted with no markings, with old bearing tree tag.

64" Fir stump, S 6 ¼ ° E, 86.5 feet (record 131 links), burnt and rotted, no markings and no tags.

50" Fir stump, S 31 ¾ ° W, 33 feet (record 50 links), burnt and rotted, no markings and no tags.


60" Fir stump, N 83 ¼ ° W, 104.9 feet (record 159 links), rotted with no marks and no tags.

22" D. Fir, S 46 ½ ° E, 93.7 feet (record 142 links), with healed face and tag.


18" D. Fir, S 60 ¾ ° W, 16.5 feet (record 25 links), with healed face and tag.

23" D. Fir, N 70 ¾ ° W, 77.9 feet (record 118 links), with healed face and tag.

**Submitted by
Gary T. Smither
P.O. Box 545
North Bend, OR 97459
541-888-2214**

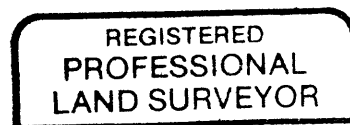

Gary T. Smither

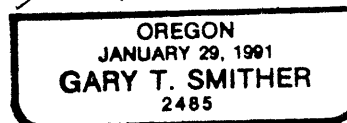

Renew 6/06

C.S. File No 65/54-7