

FILED

Date: 2-18-2005 By: JC

This survey consists of:

Map: _____

Narrative: _____

Corner Rpt: 65/54-8

DOUGLAS COUNTY
SURVEYOR

**Township 21 South, Range 8 West
Section 8**

Corner Upgrade February, 2005

S 1/4 Corner for Section 8: Found 1945 BLM Brass Cap on Iron Pipe firmly set with a steel fence post driven alongside the Brass Cap.

Old Bearing Trees:

40" Fir stump, N 4 1/2 ° E, 42.9 feet (record 65 links) with rotted out face and no markings with old bearing tree tag.

21" D. Fir, South , 20.4 feet (record 31 links) , with healed face and bearing tree tag.


New Bearing Trees:

14" D. Fir, S 65° W, 11.2 feet to spike side center, scribed T21 R8 1/4 S17 BT and bearing tree tag.


13" D. Fir, N 18° W, 21.4 feet to spike side center, scribed T21 R8 1/4 S8 BT and bearing tree tag.

12" D. Fir, N 66° E, 21.3 feet to spike side center, scribed T21 R8 1/4 S8 BT and bearing tree tag.

Submitted by
Gary T. Smither
P.O. Box 545
North Bend, OR 97459
541-888-2214

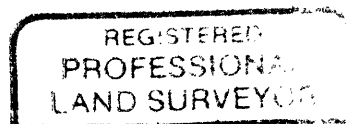

Gary T. Smither

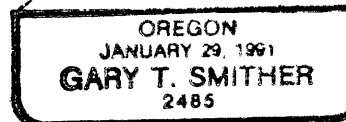

Renew 6/06

C.S. File No 65/54-8