

FILED

Date: 2-18-2005 By: JC

This survey consists of:

Map: \_\_\_\_\_

Narrative: \_\_\_\_\_

Corner Rpt: 65/54-9

DOUGLAS COUNTY  
SURVEYOR

**Township 21 South, Range 8 West  
Section 8**

**Corner Report February, 2005**

Southwest Corner for Section 8: Found 1960 Brass Cap on Iron Pipe firmly set with a steel fence post driven alongside the Brass Cap.

**Old Bearing Trees:**

23" D. Fir stump, N 31° E, 35 links, with visible scribe on burnt and rotted face.

18" D. Fir stump, S 54 ¼ ° E, 48 links, burnt and rotted, no markings.

27" Fir stump, S 57 3/4° W, 131 links, gone.

40" D. Fir stump, S 54 ½ ° E, 229 links, with visible scribe on open face and tag.

35" D. Fir stump, N 17° W, 134 links, burnt and rotted with no markings.

17" D. Fir, N 68° E, 323 links, with healed face and tag.

33" D. Fir, N 49° W, 139 links, has fallen over.


28" D. Fir, S 81 ½ ° W, 130 links, has fallen over.

13" D. Fir, S 62° W, 4.1 feet to spike side center with healed face and bearing tree tag.


12" D. Fir, N 32° W, 6.7 feet to spike side center with healed face bearing tree tag.

13" D. Fir, S 43° E, 32.0 feet to spike side center with healed face and bearing tree tag.

**Submitted by  
Gary T. Smither  
P.O. Box 545  
North Bend, OR 97459  
541-888-2214**

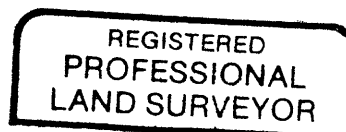

*Gary T. Smither*

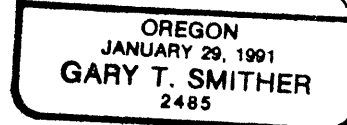

*Renew 6/06*

C.S. File No 65/54-9