

FILED
Date: 5/23/2005 By: JC
This survey consists of:
Map: _____
Name: _____
Corner File: 65/54-18

DOUGLAS COUNTY
SURVEYOR

CORNER NOTES

MAY 2005

BY: TONY HOSTETTER
63538 PINTAIL DR.
COOS BAY, OR 97420

FOR: ROSEBURG RESOURCES COMPANY
P.O. BOX 1088
ROSEBURG, OR 97470

SW CORNER, SECTION 30, T.28 S., R.8 W., W.M.
DOUGLAS COUNTY, OREGON

FOUND: 1959 BLM BRASS CAP AND 2 BTS DESCRIBED BELOW

FROM WHICH:



21" WHITE FIR, FACE EVIDENT, BT TAG,
BEARS; N 22 1/4° E, 34.0 FEET TO CENTER.

22" CEDAR, FACE EVIDENT, BLM TAG,
BEARS: N 58 3/4° W, 35.3 FEET TO CENTER.

NEW BTS:

18" FIR, SCRIBED "S31 BT",
BEARS; S 24° 29' E, 26.5 FEET TO 6" SPIKE PLACED IN ROOT COLLAR

20" CEDAR, SCRIBED "S36 BT",
BEARS; S 60° 25' W, 11.1 FEET TO 6" SPIKE PLACED IN ROOT COLLAR.

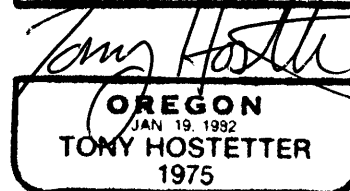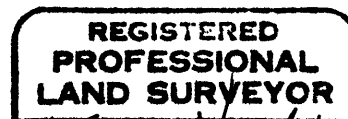

EXP DATE 6-30-05

C.S. File No 65/54-18