



GARY T. SMITHER

Professional Land Surveyor
Certified Water Rights Examiner

FILED

Date: 6-1-2005 By: J

This survey consists of:

Map: _____

Number: _____

Corner Rpt: 65/54-21

DOUGLAS COUNTY
SURVEYOR

Township 21 South, Range 8 West Section 36

South ¼ Corner for Section 36 only: Found 1952 Brass Cap on Iron Pipe firmly set. Set 6 foot Steel Post alongside.

Old Bearing Trees:

70" Fir stump, N 40° E, 16.5 feet, rotted with no markings.

54" Fir stump, N 7° E, 30.4 feet, with visible scribes and bearing tree tag.

21" Maple, N 37° E, 78.2 feet, with healed face and bearing tree tag.

2000 Bearing Trees:

17" D. Fir, N 69° E, 47.1 feet to spike side center, with healed face and bearing tree tag.



8" D. Fir, N 39° W, 19.6 feet to spike side center, with healed face and bearing tree tag.

New Bearing Tree:

18" Fir, S 52° E, 8.8 feet to spike set side center, scribed "T21 R8 ¼ S36 BT", with bearing tree tag .

888-2214

FAX and Phone (541) 751-9624
P.O. Box 545, North Bend, OR 97459

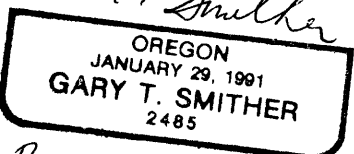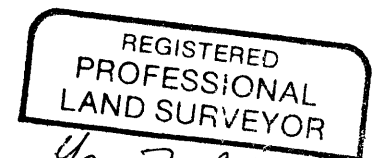

Yours Truly
Renewal 6/06
C.S. File No 65/54-21