

FILED

Date 6/28/05 AKS
Township 19 Sec of 24
Range 3W
Date 6/15/2005
Corner fpt: 65/54-24

CORNER REPORT FORM

Section 19 Township 245 Range 3W
Douglas County Date 6/15/2005

CORNER DESIGNATION

NORTH 1/4 SEC 19
REFERENCE NUMBER 140400

Condition Report on ✓
Not Found
X Renewed
Unrecorded
Surveyed In
Referenced out

DOUGLAS COUNTY SURVEYOR

Previous Renewals/Surveys, etc:

- 1) GLO VOLUME 7, PAGE 3010
- 2) DCSO RECORD VOLUME 27, PAGE 11486

Monument(s) & Accessories Found: (Condition and Source)

SEE NOTE →

23" HEMLOCK STUMP W/YELLOW METAL LOCATION POSTER
BEARS N37°20'20"E 25.1'

34" HEMLOCK PARTIALLY HEALED SCRIBE AND YELLOW METAL LOCATION
POSTER BEARS S24°30'30"W 42.2'

NOTES

CHAMPION INTERNATIONAL CORPORATION POSTED AN ADDITIONAL YELLOW
METAL LOCATION POSTER WHICH READS "S39°W 25.1' TO S 1/4" 9/85
Sketch

Monument Detail

SET 5/8" X 30" IRON ROD W/YELLOW PLASTIC CAP
INSCRIBED "AKS ENGR." FOR NORTH 1/4 SEC 19.
STEEL POST WAS SET 0.2' SOUTH OF MONUMENT

Monument Set (Procedures and Description)

RECORD DISTANCE OF 42.2' (64 LINKS) WAS HELD PER
DEPENDANT RESURVEY BY NORMAN D. PRICE, JUNE/AUG 1950.
RECORD DISTANCE OF 25.1' WAS HELD PER CHAMPION INTERNATIONAL
CORPORATION, LS 1988, 9/85

New Accessories

SET 5/8" X 30" IRON ROD W/RED PLASTIC CAP INSCRIBED
"AKS ENGR." FOR WITNESS MONUMENT.
BEARS N17°03'42"W 15.36' FROM NORTH 1/4 SEC 19

Location & Comments

RECORD BT 9" HEMLOCK DISTANCE
OF 28 LINKS WAS FOUND
INACCURATE. DISCREPANCY WAS
FOUND BY CHAMPION INTERNATIONAL
CORPORATION AND CORRECTED
IN FIELD.

Compass Declination


Firm/Agency:
AKS ENGINEERING & FORESTRY
13.910 SW GALBREATH DR
ADDRESS: SUITE 100
SHELLWOOD, OR 97140

Party Chief:

Notes: MIKE KOMISKIEY

Witness: CHRIS HUSTETLER

Surveyor's Seal 6-20-05

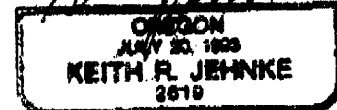

C.S. File No 65/54-24