

FILED
Date: 7-26-2005 By: SC

This survey consists of:

Map: _____

Corner Rpt: 65/54-27

OREGON CORNER RESTORATION FORM

Section: 11 Township: 21S Range: 12W

County: Douglas Date: 07/19/05

**DOUGLAS COUNTY
SURVEYOR**

Corner Designation

E 1/16 S2 and S11

- Condition Report Only
- Not Found
- Renewed
- Unrecorded
- Surveyed In
- Referenced Out

Previous Renewals/Surveys, etc.:

A 1980 survey by Richard Hintz (M79-30), and a 1997 survey by Clyde Mulkins (M127-39)

Monument(s) & Accessories Found: (Condition and Source)

Fd. 2" iron pipe with 2 1/2" brass cap marked "PLS497 T21S R12W E1/16 2 11 1979"


Record Fir Bt with healed face and tag is uprooted

Record Spruce Bt with tag uprooted

Remains of rusted metal fence post bears north 1.5 FT

Monument Detail:

Sketch:

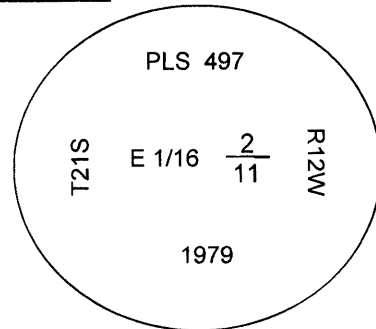

Monument Set (Procedures and Description):

New Accessories:

17" Fir, S50°E 44.3FT, scribed "1/16 S11 BT".

29" Hemlock Stump, S37°W 39.8FT to spike set in top

Location and Comments:


Distance measured to
spike set at side center on
new BT. Tag attached to
tree facing the corner

Compass Declination: 18°E
Firm/Agency: Menasha
Forest Products Corp.
Address: PO Box 588
North Bend, OR 97459

Party Chief: Brent Bacon
Notes: Brent Bacon

Witness: Doyce Rose

Surveyor's Seal

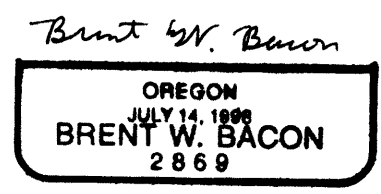

Expires 12-31-2005