

OREGON CORNER RESTORATION FORM

Date: 8-16-2005 By: JC

This survey consists of:

Map: _____

Narrative: _____

Corner Ept: 65/54-33

Section: 22 Township: 30S Range: 03W

County: Douglas Date: 8-09-05

DOUGLAS COUNTY SURVEYOR

Corner Designation

1/4 S15 / S22

- Condition Report Only
Not Found
Renewed
Unrecorded
Surveyed In
Referenced Out


Previous Renewals / Surveys, etc.:

GLO in 1893 by William Bushey; Corner was set by proportion in 1972 (see BLM survey by Albright and Bowder).


Monument (s) & Accessories Found: (Condition & Source)

Found brass cap set by BLM in 1972
21 1/2" fir bears N44°E 47.40'
28 1/2" fir bears S60°W 62.60'

Monument Detail:

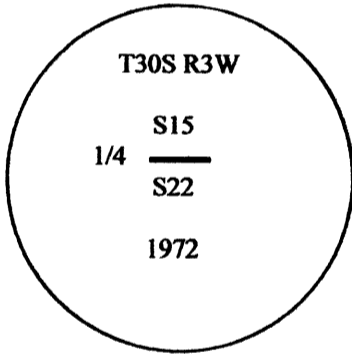

Sketch:

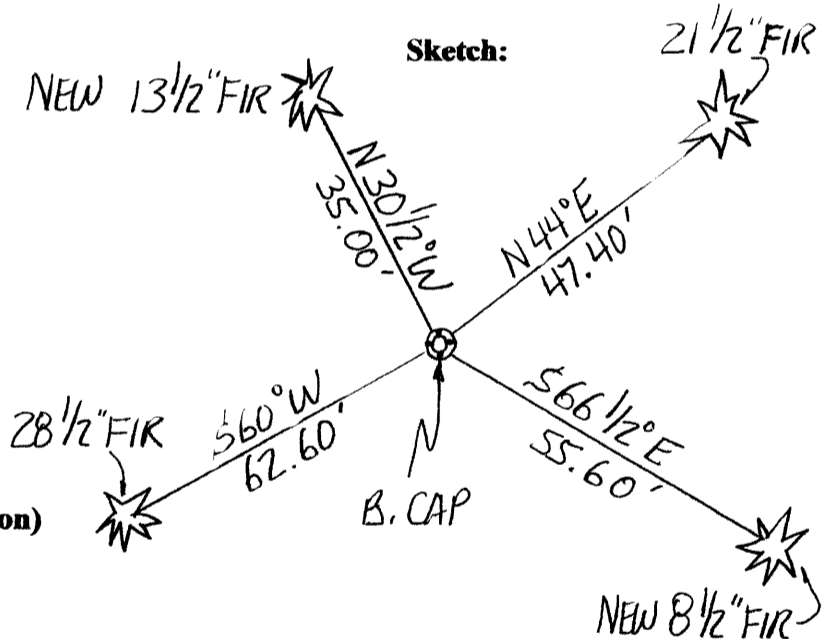

Monument Set (Procedures and Description)

N/A

New Accessories

8 1/2" fir bears S66 1/2°E 55.60' scribed "1/4 S22 BT"
13 1/2" fir bears N30 1/2°W 35.00' scribed "1/4 S15 BT"

NOTE: We set and measured to spikes in the base of all bearing trees; bearings to the trees are based on BLM's survey of the West line of Section 22.

Location & Comments

Corner is located on a spur sloping to the south. There is a road approximately 550' South of the corner. The same road is also about 500' West of the corner.

Compass Declination: N/A

Firm/Agency:

Gregory D. Lang, Surveyor
Address: 7550 Willis Cr. Rd.
Winston, Oregon 97496

Party Chief: Trevor Lang

Notes: Same

Witness: Joel Herzberg

Surveyor's Seal

REGISTERED PROFESSIONAL LAND SURVEYOR

Signature of Gregory D. Lang
OREGON JULY 18, 1987
GREGORY D. LANG
92296

EXPIRES 12-31-2006

C.S. File No 65/54-33