

MAP OF SURVEY

LOCATED in the NW 1/4 of Section 16, T. 26 S.,
R. 7 W., W.M. in Douglas County, Oregon.

July 5, 2005

SURVEYED FOR: *SENECA JONES TIMBER COMPANY*
P.O. BOX 2129
ROSEBURG, OREGON 97470

SURVEYED BY: *DAVID EDWARDS LAND SURVEYING*
P.O. BOX 361
OAKLAND, OREGON 97462
PHONE: (541) 459-0512

FILED
Date: 7-7-2005 By: JC
This survey consists of:
Map: 65/55-6
Narrative:
Corner Rpt: _____
DOUGLAS COUNTY
SURVEYOR

REGISTERED
PROFESSIONAL
LAND SURVEYOR

David A. Edwards

OREGON
JULY 26, 1908
DAVID A. EDWARDS
2339
RENEWS 12731705

LEGEND


⊙ INDICATES B.L.M. BRASS CAP FOUND PER 1967 RESURVEY.

() DENOTES RECORD DATA PER 1967 B.L.M. RESURVEY.

———— INDICATES LINE POSTED, BLAZED AND PAINTED THIS SURVEY.

SCALE: 1" = 1000'

BASIS OF BEARINGS: EXISTING CONTROL PER MY SURVEY C.S. 65/41-2.

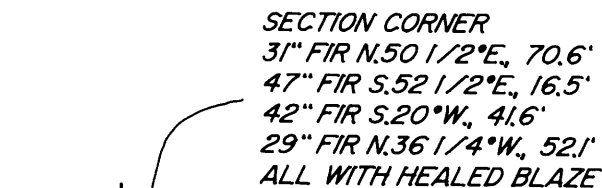

NARRATIVE

THE PURPOSE OF THIS SURVEY IS TO MARK THE WEST LINE OF THE NW 1/4 OF SECTION 16. A TRAVERSE WAS RUN WHICH TIED THE SECTION AND 1/4 CORNERS TOGETHER. OFFSETS WERE THEN MADE TO THE TRUE LINE WHICH WAS MARKED BY BLAZING TREES ON EACH SIDE OF THE LINE, BY SETTING 6 FOOT STEEL POSTS ALONG LINE AT INTERVALS OF 200 FEET OR LESS AND BY HANGING LIBERAL AMOUNTS OF RED FLAGGING ALONG SAID TRUE LINE.

FIELD CREW: BRANT MILLER AND ERIC SPRINKLE.

EQUIPMENT: NIKON TOTAL STATION.

COMPS. AND DRAFTING: DAVID EDWARDS.

1/4 CORNER FOUND
AS PER C.S. 65/41-2

C.S. File No 65/55-6