


THIS IS TO CERTIFY THAT I SURVEYED THE PROPERTY DEPICTED HEREIN AND THAT I FIND THE IMPROVEMENTS SITUATED THEREON TO BE ON THE PREMISES IN QUESTION AND THAT THEY DO NOT OVERLAP OR ENCRANCH ON THE PROPERTY LYING ADJACENT THERETO.

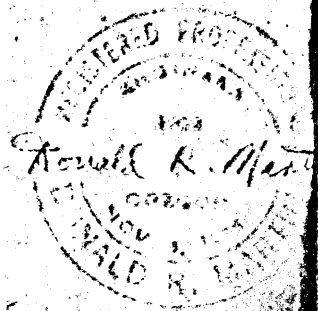

Ronald R. Martin

APRIL 1967

FIELD SURVEY & PLAT FOR
ROBERT D. CREECH
RIDDLE, OREGON

PARCEL IN EAST 1/2 SEC. 33 T30S R6W W.M.
DOUGLAS COUNTY, OREGON

SCALE: 1" = 50'

MARTIN ENGINEERING SERVICE - MYRTLE CREEK