

21772 0 10 800

Sept. 1952

FILED

Date: 4-26-2006 By: N


This survey consists of:

Map: CS 65/57-7

Narrative:

Corner Rpt:

DOUGLAS COUNTY SURVEYOR

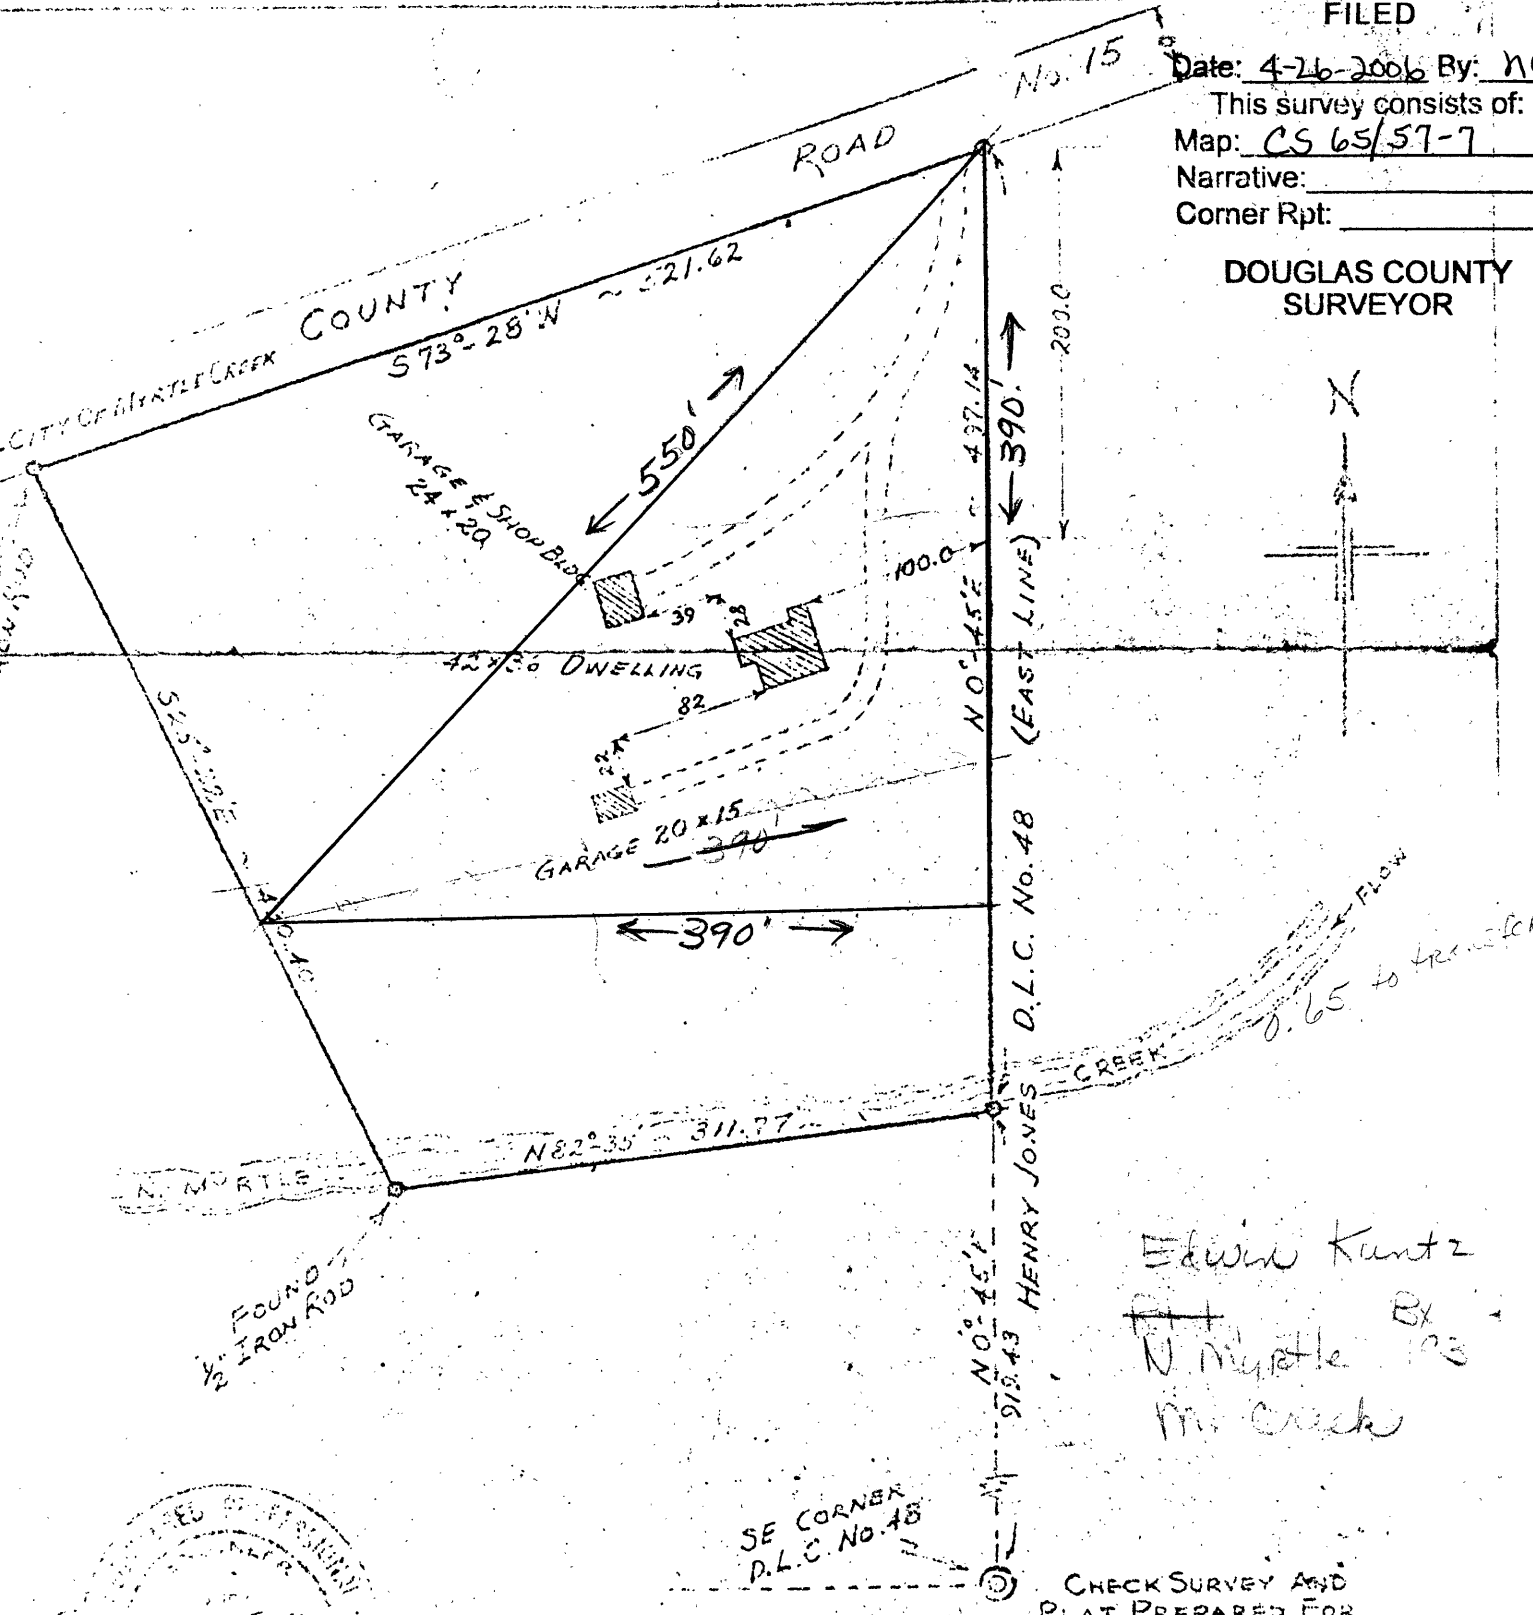

Edwin Kuntz  
 N. Myrtle Crk  
 Mr. Creek



SE CORNER  
 D.L.C. No. 48

CHECK SURVEY AND  
 PLAT PREPARED FOR

MYRTLE REALTY CO.  
 MYRTLE CREEK, ORS.

CHARLES BARE PROPERTY ~ N. MYRTLE CREEK  
 SEC. 13 T29S R5W W.M. DOUGLAS COUNTY OREGON

SCALE: 1" = 100 FT.

C.S. File No 65/57-7

MADE BY [unclear]