

FILED

Date: 3/27/2006 By: SC

This survey consists of:

Map: _____

Narrative: _____

Corner Rpt: 65/58-4

OREGON CORNER RESTORATION FORM

Section 20 Township 23S Range 6W

County DOUGLAS Date 3-8-06

Corner Designation

CE 1/16

- Condition Report Only
- Not Found
- Renewed
- Unrecorded
- Surveyed In
- Referenced Out

DOUGLAS COUNTY SURVEYOR

Previous Renewals/Surveys, etc. _____

Monument(s) & Accessories Found: (Condition and Source)

1994 STAINLESS STEEL PIPE & BRASS CAP WITH MOUND OF STONE


1983 REFERENCE MONUMENT 558°53'30"W 29'

22" FIB S22 1/2° W 37' GOOD CONDITION - HEALED FACE

12" HEMLOCK S83°W 31' GOOD CONDITION - HEALED FACE

Monument Detail

Sketch

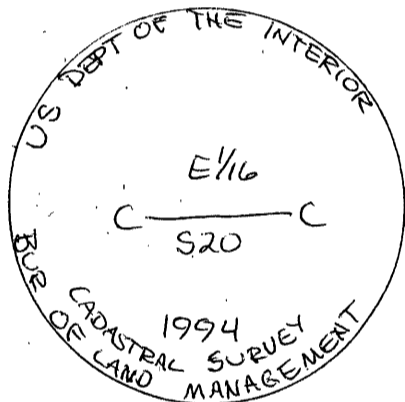

Monument Set (Procedures and Description)

New Accessories

Location & Comments

Surveyor's Seal

Compass Declination 16°

Firm/Agency ROSEBURG

FOREST PRODUCTS


Address PO Box 1088

ROSEBURG OREGON 97470

Party Chief Bill Olson

Notes _____

Witness RALPH McMANIS

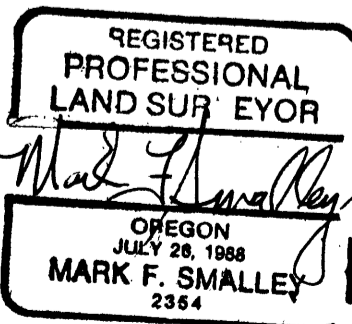

Renews 6/30/06

C.S. File No 65/58-4