

FILED

Date: 3/27/2006 By: SC

This survey consists of:

Map: _____

Narrative: _____

Corner Rpt: 65/58-6

DOUGLAS COUNTY
SURVEYOR

OREGON CORNER RESTORATION FORM

Section 20 Township 23S Range 6W

County DOUGLAS Date 3-8-06

Corner Designation

E $\frac{1}{16}$ $\frac{S20}{S29}$

- Condition Report Only
- Not Found
- Renewed
- Unrecorded
- Surveyed In
- Referenced Out

Previous Renewals/Surveys, etc. _____

Monument(s) & Accessories Found: (Condition and Source)


1994 BLM STAINLESS STEEL PIPE & BRASS CAP

20" FIR S87 $\frac{3}{4}$ W 39 $\frac{6}{8}$ GOOD CONDITION & HEALED FACE

26" FIR N5W 22 $\frac{4}{8}$ GOOD CONDITION - HEALED FACE (REC. - 30")

Monument Detail

Sketch

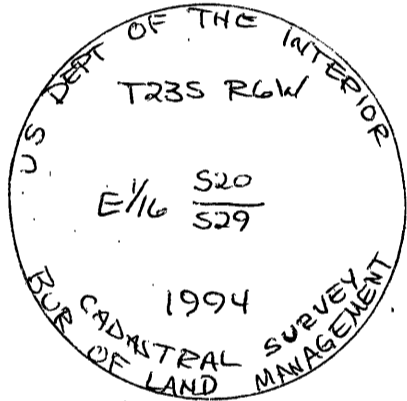

Monument Set (Procedures and Description)

New Accessories

Location & Comments

REFERENCE MONUMENT _____

NOT FOUND _____

Compass Declination 16°

Firm/Agency ROSEBURG FOREST PRODUCTS


Address PO Box 1088 ROSEBURG OREGON 97470

Party Chief Bill Olson

Notes _____

Witness RALPH McMANIS

Surveyor's Seal

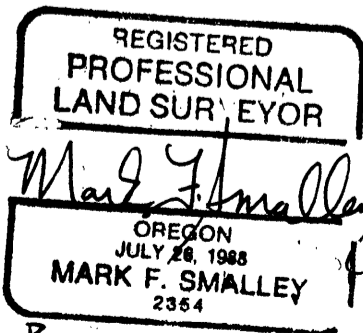

Renews 6/30/06

C.S. File No 65/58-6