

D
M
N
C

OREGON CORNER RESTORATION FORM

Section 20 Township 21S Range 8W

County Douglas Date 3/27/2006

Corner Designation

Section Corner

Sections 16, 17, 20, 21

Previous Renewals/Surveys, etc.

See Douglas County Corner care

Monument(s) & Accessories Found: (Condition)

Found 1945 2 1/2" GLD brass cap as shown following accessories;


25" D. fir bears N. 54° E., 38.3 ft

28" D. fir bears S. 34 1/2° W., 42.2 ft

11" D. fir bears N. 55 1/2° W., 87.1 ft

19" D. fir bears N. 65° W., 18.8 ft

Monument Detail

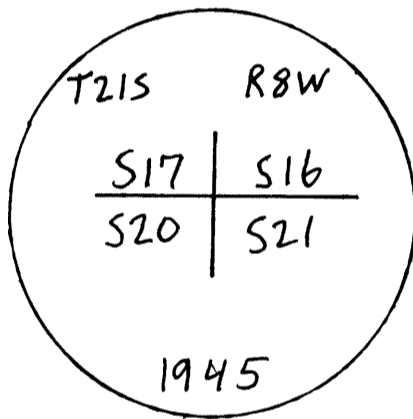

Monument Set (Procedures and Description)

none

New Accessories

none

Location & Comments

A 5-1/2' galvanized steel post is set adjacent to corner.

All BTs have red painted bands and yellow BT tags.

Compass Declination 1'

Firm/Agency Ward Northwest, INC.

Address P.O. Box 103 Florence, OR 97430

Party Chief Josh Ree

Notes Job # 05-116

Witness Derek Mart