

FILED

Date: 4-18-2006 By: JC

This survey consists of:

Map: _____

Narrative: _____

Corner Rpt: 65/58-13

OREGON CORNER RESTORATION FORM

Section 20 Township 21S Range 8W

County Douglas Date 3/27/2006

DOUGLAS COUNTY
SURVEYOR

Corner Designation

Witness Corner
1/4 Corner Sections 17, 20

- Condition Report Only
- Not Found
- Renewed
- Unrecorded
- Surveyed In
- Referenced Out

Previous Renewals/Surveys, etc. _____

See Douglas County Corner card # 240400

Monument(s) & Accessories Found: (Condition and Source)


Found 1945 2 1/2" GLD brass cap as shown with the following accessories;

70" Rotted D. fir stump bears N. 47° W., 68.0 ft (rotted face)

50" Rotted D. fir stump bears S. 27° E., 145.2 ft (rotted face)

Monument Detail

Sketch

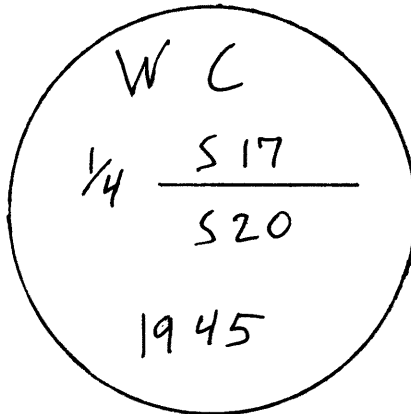

Monument Set (Procedures and Description)

None

New Accessories

16" D. fir bears N. 17° E., 2.65 ft

14" D. fir bears S. 73° E., 3.8 ft

14" D. fir bears N. 31° W., 28.25 ft

14" D. fir bears S. 55° W., 26.0 ft

All new BT's scribed "X" at breast height and "BT" at base

Location & Comments

Surveyor's Seal

Set 5-1/2' galvanized steel post adjacent to corner. Compass Declination 17° 30'
Firm/Agency Ward Northwest, INC.

All new BT's have red painted bands and yellow BT tags. Address P.O. Box 105 Florence, OR 97439

Party Chief Josh Reed

Notes Job # 05-116

Witness Derek Martin

REGISTERED
PROFESSIONAL
LAND SURVEYOR

Ronald L. Rice
OREGON
JULY 9, 2002
RONALD L. RICE
#54633 LS

EXPIRES: 12-31-06

C.S. File No 65/58-13