

FILED

Date: 4-18-2006 By: JC

This survey consists of:

Map: _____

Narrative: _____

Corner Rpt: 65/58-14

OREGON CORNER RESTORATION FORM

Section 20 Township 21 S Range 8 W

County Douglas Date 3/27/2006

DOUGLAS COUNTY SURVEYOR

Corner Designation

1/4 Corner Sections 19, 20

Condition Report Only

Not Found

Renewed

Unrecorded

Surveyed In

Referenced Out

Previous Renewals/Surveys, etc. _____

See Douglas County Corner card # 200340

Monument(s) & Accessories Found: (Condition and Source)


Found 1945 2 1/2" GLO brass cap as shown with the following accessories;

70" Rotted D. fir stump bears N. 18 1/2° E., 37.6 ft (rotted face)

60" Rotted D. fir stump bears N. 42° W., 50.2 ft (rotted face)

Monument Detail

Sketch

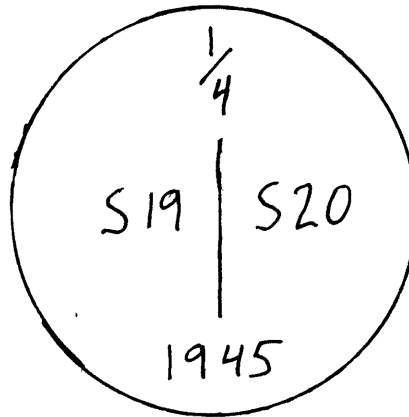

Monument Set (Procedures and Description)

none

New Accessories

23" D. fir bears N. 17 1/2° E., 32.98 ft (scribed "1/4 S20 BT")

18" D. fir bears N. 70 1/4° E., 23.26 ft (scribed "1/4 S20 BT")

17" D. fir bears S. 76° W., 11.99 ft (scribed "1/4 S19 BT")

23" D. fir bears N. 47 1/4° W., 43.36 ft (scribed "1/4 S19 BT")

Location & Comments

Set 5-1/2' galvanized steel post adjacent to corner.

All new BT's have red printed bands and yellow BT tags.

Compass Declination 17° 30'

Firm/Agency Ward Northwest, INC.

Address P.O. Box 105 Florence, OR 97439

Party Chief Josh Reed

Notes Job # 05-116

Witness Derek Martin

Surveyor's Seal

REGISTERED PROFESSIONAL LAND SURVEYOR

Ronald L. Rice
OREGON
JULY 9, 2002
RONALD L. RICE
#54633 LS

EXPIRES: 12-31-06

C.S. File No 65/58-14