

FILED

Date: 4-18-2006 By: JC

This survey consists of:

Map: \_\_\_\_\_

Narrative: \_\_\_\_\_

Corner Rpt: 65/58-15

OREGON CORNER RESTORATION FORM

Section 20 Township 21S Range 8W

County Douglas Date 3/27/2006

DOUGLAS COUNTY  
SURVEYOR

Corner Designation

Section Corner  
Sections 17, 18, 19, 20

- Condition Report Only
- Not Found
- Renewed
- Unrecorded
- Surveyed In
- Referenced Out

Previous Renewals/Surveys, etc. \_\_\_\_\_


See Douglas County Corner card #200400

Monument(s) & Accessories Found: (Condition and Source)

Found 1945 2 1/2" 6LO brass cap as shown with the following accessories;  
37" D. fir stump bears N. 45° W., 114.8 ft (healed face)  
30" D. fir bears N 83° E., 54.8 ft (healed face)  
28" Maple bears S. 12° E., 15.2 ft (healed face)  
31" R. Cedar bears S 67° W., 56.1 ft (healed face)

Monument Detail

Sketch

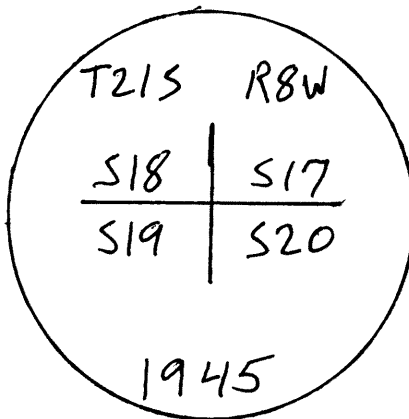

Monument Set (Procedures and Description)

none

New Accessories

none

Location & Comments

A 5-1/2' galvanized steel post is set adjacent to corner. All BT's have red painted bands and yellow BT tags.

Compass Declination 17° 30'  
 Firm/Agency Ward Northwest, INC.  
 Address P.O. Box 105 Florence, OR 97439  
 Party Chief Josh Reed  
 Notes Job # 05-116  
 Witness Derek Martin

Surveyor's Seal

REGISTERED  
PROFESSIONAL  
LAND SURVEYOR

Ronald L. Rice  
 OREGON  
 JULY 9, 2002  
 RONALD L. RICE  
 #54633 LS

EXPIRES: 12-31-06

C.S. File No 65/58-15