

FILED

Date: 8-2-2006 By: X

This survey consists of:

Map: _____

Narrative: _____

Corner Rpt: 65/58-19

CORNER REPORT FORM

Section 18 Township 215 Range 11W

Douglas County Date 7/28/06

CORNER DESIGNATION

POL BETWEEN 1/4 13/18
9' 13/18
24' 19

Condition DOUGLAS COUNTY
 Not Found SURVEYOR
 Renewed
 Unrecorded
 Surveyed In
 Referenced out

Previous Renewals/Surveys, etc:

SET BY COUNTY SURVEYOR 1970 CS 54/110
A 5/8 I. ROD 9 MKD 36" DOUBLE SPRUCE N24E-97.0'
Monument(s) & Accessories Found: (Condition and Source)

997 48' SOUTH OF 1/4 13/18 FOUND A TIPPED
OVER 5/8 I. ROD - DUG DOWN ALONGSIDE
ITS LENGTH TO THE END. RESET THE
ROD VERTICAL AT THAT POINT. A TRIPLE
SPRUCE ABOUT 48" BEARS N28E-95.6'
ROD FALLS ON W. EDGE OF DIRT - RECORD
OLD FENCE IN THIS AREA IS GONE.


SPRUCE SHOWS DEFINITE HEALED OVER BLAZE
Monument Detail WITH I DID NOT OPEN Sketch

TIE TO THE BT IS BY INSTRUMENT
DOUGLAS COUNTY BEARINGS

Monument Set (Procedures and Description)

Above

New Accessories

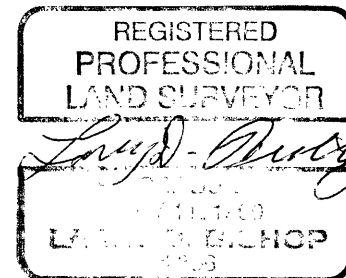

EXPIRATION DATE 12/31/07

(copied in CS 54/110)

C.S. File No 65/58-19