

CORNER REPORT FORM

Section 36 Township 29S Range 7W
Douglas County Date 11-10-06

CORNER DESIGNATION

E 1/16 25
36

Previous Renewals/Surveys, etc:

Survey 1193-45

Monument(s) & Accessories Found: (Condition and Source)

MONUMENT & ACCESSORIES AS RECORDED &
IN GOOD CONDITION.

Monument Detail

Sketch

Monument Set (Procedures and Description)

New Accessories

ADDED BT TAG'S ON ORIG. TREES

Location & Comments

Compass Declination

Firm/Agency: i.e. Engineering, Inc.

Address: 505 SE Main
Roseburg, OR 97470

Party Chief: FIDMANK

Notes:

Witness: MAXWELL

FILED



Date: 11-16-2006 By: X
This survey consists of:

Condition Map only
Not Found
Renewed
Unrecorded
Surveyed In
Referenced out

Narrative:
Corner Rpt: 65/58-20

DOUGLAS COUNTY
SURVEYOR

Surveyor's Seal

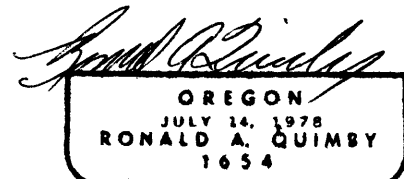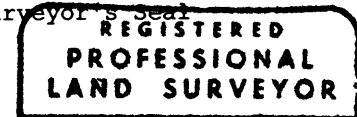

C.S. File No 65/58-20