

FILED

Date: 12-4-2006 By: X

This survey consists of:

Map: \_\_\_\_\_

Narrative: \_\_\_\_\_

Corner Rpt: 65/58-22

DOUGLAS COUNTY  
SURVEYOR

OREGON CORNER RESTORATION FORM

Section 6 Township 30S Range 7W

County DOUGLAS Date 10-6-06

Corner Designation

100600

- Condition Report Only
- Not Found
- Renewed
- Unrecorded
- Surveyed In
- Referenced Out


Previous Renewals/Surveys, etc. \_\_\_\_\_

Monument(s) & Accessories Found: (Condition and Source)

1964 DCSO IPBC

- BTs: ORIGINAL 26" CEDAR N64E 34° LYING BY CORNER MONUMENT (ORIG)
- 42" PINE STUMP S24W 36° GONE (ORIG)
- 40" CEDAR S46E 16° DOWN
- 16" CEDAR STUMP N11W 33° GONE
- 13" FIR S28E 16° GOOD CONDITION - HEALED FACE (REC 526E)
- 12" W. FIR S60W 11° GOOD CONDITION - HEALED FACE
- 24" W. FIR N72W 54° GOOD CONDITION - HEALED FACE (REC 556)
- 36" Fir N79W 38° "X" scribed in Bark - 1958 tag
- 38" Fir N60E 38° Good Condition - Healed Face

Monument Detail

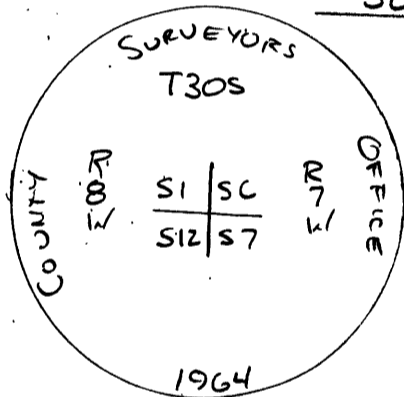

Monument Set (Procedures and Description)

\_\_\_\_\_  
 \_\_\_\_\_  
 \_\_\_\_\_  
 \_\_\_\_\_


New Accessories

\_\_\_\_\_  
 \_\_\_\_\_  
 \_\_\_\_\_  
 \_\_\_\_\_

Location & Comments

Compass Declination 16 1/2  
 Firm/Agency ROSEBURG  
FOREST PRODUCTS  
 Address PO Box 1088  
ROSEBURG OREGON 97470  
 Party Chief Bill Olson  
 Notes \_\_\_\_\_  
 Witness RALPH McMANIS

Surveyor's Seal

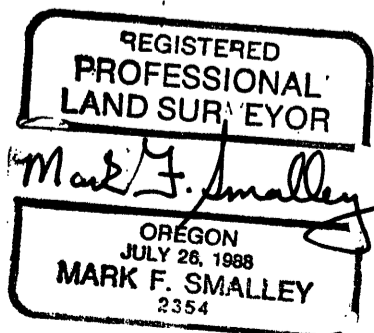

C.S. File No 65/58-22