

FILED

Date: 12-4-2006 By: JC

This survey consists of: \_\_\_\_\_

Map: \_\_\_\_\_

Narrative: \_\_\_\_\_

Corner Rpt. 65/58-23

DOUGLAS COUNTY  
SURVEYOR

OREGON CORNER RESTORATION FORM

Section 6 Township 30S Range 7W

County DOUGLAS Date 9-11-06

Corner Designation

100640

Condition Report Only

Not Found

Renewed

Unrecorded

Surveyed In

Referenced Out

Previous Renewals/Surveys, etc. \_\_\_\_\_

Monument(s) & Accessories Found: (Condition and Source)


1964 DCSD IPBC

BTs: 56" FIR S40E 5<sup>3</sup> POOR CONDITION - BARK SCRIBE

11" FIR NBOW 3<sup>3</sup> GOOD CONDITION - HEALED FACE

Monument Detail

Sketch

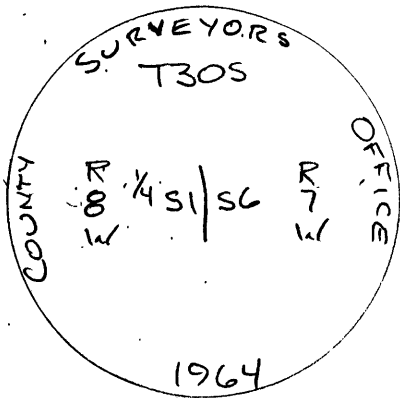

Monument Set (Procedures and Description)

New Accessories

SCRIBED: 9" FIR N68W 21<sup>5</sup> SCRIBED "1/4 S BT"  
10" FIR N18E 23<sup>0</sup> SCRIBED "1/4 S BT"

Location & Comments

Compass Declination 16 1/2<sup>0</sup>

Firm/Agency ROSEBURG

FOREST PRODUCTS

Address PO Box 1088

ROSEBURG OR 97470

Party Chief Bill Olson

Notes \_\_\_\_\_

Witness RALPH McMANIS

Surveyor's Seal

REGISTERED  
PROFESSIONAL  
LAND SURVEYOR

*Mark F. Smalley*

OREGON  
JULY 26, 1988  
MARK F. SMALLEY  
2354

Renews 6/30/2008

C.S. File No 65/58-23