

FILED

Date: 12-4-2008 By: JL

This survey consists of:

Map: _____

Narrative: _____

Corner Rpt: 65/58-24

DOUGLAS COUNTY
SURVEYOR

OREGON CORNER RESTORATION FORM

Section 6 Township 30S Range 7W

County DOUGLAS Date 10-6-06

Corner Designation

100700

- Condition Report Only
- Not Found
- Renewed
- Unrecorded
- Surveyed In
- Referenced Out

Previous Renewals/Surveys, etc. _____

Monument(s) & Accessories Found: (Condition and Source)

1962 DCSO IPBC


BTs: 43" CEDAR S56E 12⁵ CENTER ROTTED AWAY - AXE WORK VISIBLE

14" HEMLOCK N1E 10⁷ DOWN-ROTTED FACE

23" CEDAR S71¹/₂W 21⁰ GOOD-HEALED FACE

Monument Detail

Sketch

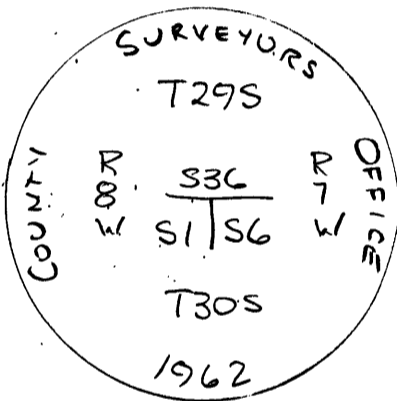

Monument Set (Procedures and Description)

New Accessories

SCRIBED: 22" CEDAR N73W 46⁸ SCRIBED "SG BT"

10" FIR N22E 20¹ SCRIBED "SG BT"

Location & Comments

Compass Declination 10²

Firm/Agency ROSEBURG

FOREST PRODUCTS

Address PO Box 1088

ROSEBURG OREGON 97470

Party Chief Bill Olson

Notes _____

Witness RALPH McMANIS

Surveyor's Seal



Renews 6/30/2008

C.S. File No 65/58-24