

FILED

Date: 2/22/2007 By: JC

This survey consists of:

Map: _____

Narrative: _____

Corner Rpt: 65/60-4

OREGON CORNER RESTORATION FORM

Section 5 Township 28S Range 4W

County DOUGLAS Date 5-9-06

DOUGLAS COUNTY
SURVEYOR

Corner Designation

SE 1/16

- Condition Report Only
- Not Found
- Renewed
- Unrecorded
- Surveyed In
- Referenced Out

Previous Renewals/Surveys, etc. _____


Monument(s) & Accessories Found: (Condition and Source)

BTs: 17" FIR S12 1/4 E 31 1/2 GOOD CONDITION - HEALED FACE

21" FIR N84W 43 1/2 GOOD CONDITION - HEALED FACE

Monument Detail

Sketch

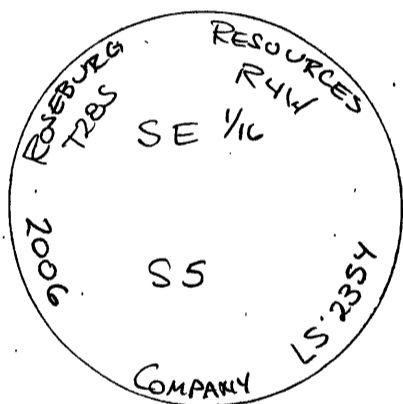

Monument Set (Procedures and Description)

5/8" X 50" IRON ROD WITH ALUMINUM CAP

New Accessories

Location & Comments

Compass Declination 18 1/2°

Firm/Agency ROSEBURG

FOREST PRODUCTS

Address P.O. Box 1088


ROSEBURG OR 97470

Party Chief Bill Olson

Notes _____

Witness KEV COBLE

Surveyor's Seal

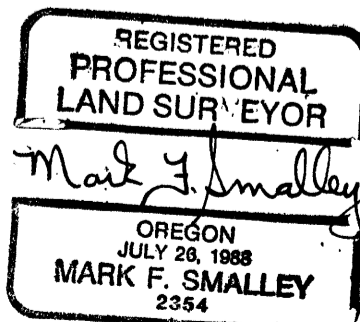

Renews 6/30/08

C.S. File No 65/60-4

260620