

FILED

Date: 2/22/2007 By: X

This survey consists of:

Map: _____

Narrative: _____

Corner Rpt: 65/60-5

OREGON CORNER RESTORATION FORM

Section 5 Township 28S Range 4W

County DOUGLAS Date 5-9-06

DOUGLAS COUNTY
SURVEYOR

Corner Designation

300640

S¹/₁₆ 5/4

- Condition Report Only
- Not Found
- Renewed
- Unrecorded
- Surveyed In
- Referenced Out

Previous Renewals/Surveys, etc. _____

Monument(s) & Accessories Found: (Condition and Source)

1967 BLM IPBC

BTS: 27" FIR N86E 11² GOOD CONDITION HEALED FACE

41" FIR S65³/₄E 46² GOOD CONDITION HEALED FACE

Monument Detail

Sketch



Monument Set (Procedures and Description)

New Accessories

Location & Comments

Surveyor's Seal

Compass Declination 18 1/2°

Firm/Agency ROSEBURG

FOREST PRODUCTS


Address P O Box 1088

ROSEBURG OR 97470

Party Chief Bill Olson

Notes _____

Witness KEN COBLE

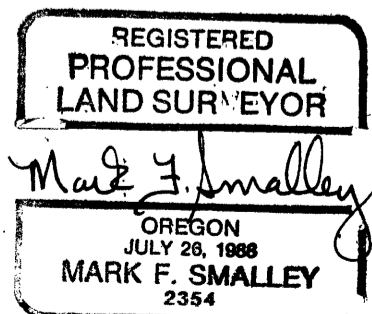

Renews 6/30/08

C.S. File No 65/60-5

300 620