

FILED

Date: 2/22/2007 By: XC

This survey consists of:

Map: _____

Narrative: _____

Corner Rpt: 65/60-8

DOUGLAS COUNTY SURVEYOR

OREGON CORNER RESTORATION FORM

Section 5 Township 28S Range 4W

County DOUGLAS Date 5-9-06

Corner Designation

INTERIOR CORNER

- Condition Report Only
- Not Found
- Renewed
- Unrecorded
- Surveyed In
- Referenced Out

Previous Renewals/Surveys, etc. _____

Monument(s) & Accessories Found: (Condition and Source)


1967 BLM IFBC

BTs: 33" FIR STUMP S17 1/2 E 30'

41" FIR S53W 63' GOOD CONDITION HEALED FACE

Monument Detail

Sketch

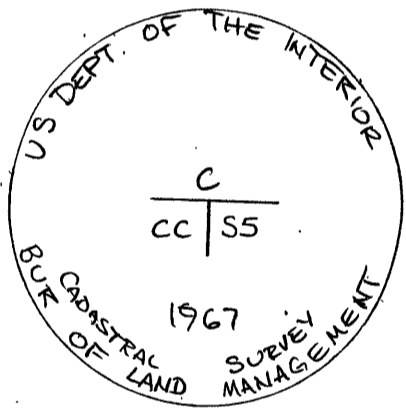

Monument Set (Procedures and Description)

New Accessories

BTs: 22" MYRTLE S54 E 83' SCRIBED "DLC BT"

Location & Comments

Compass Declination 18 1/2 °

Firm/Agency ROSEBURG

FOREST PRODUCTS

Address P.O. Box 1088


ROSEBURG OR 97470

Party Chief Bill Olson

Notes _____

Witness KEN COBLE

Surveyor's Seal

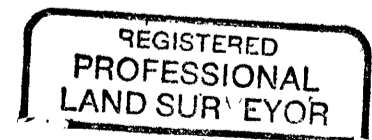

Mark J. Smalley

OREGON
JULY 23, 1933
MARK J. SMALLEY

Renews 6/30/08
C.S. File No 65/60-8